

STATE ENGINEER  
Salem, Oregon

# Well Record

STATE WELL NO. 26/33-33K(1)  
COUNTY Harney  
APPLICATION NO. U-873


Harney 1405

OWNER: Herbert Davis MAILING ADDRESS: \_\_\_\_\_

LOCATION OF WELL: Owner's No. \_\_\_\_\_ CITY AND STATE: Princeton

.....NW ¼ SE ¼ Sec. 33 T. 26 N. S, R. 33 E, W.M.

Bearing and distance from section or subdivision  
corner N. 39° 44' W. 3312' from SE cor. Sec. 33

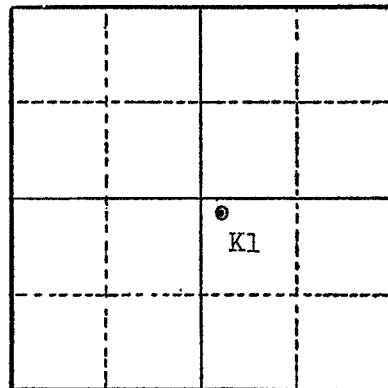

Altitude at well 4128'

TYPE OF WELL: Drilled Date Constructed 1954

Depth drilled 110 Depth cased \_\_\_\_\_

Section 33

### CASING RECORD:

14-inch

### FINISH:

### AQUIFERS:

Basalt and cinders

### WATER LEVEL:

29' below land surface

PUMPING EQUIPMENT: Type \_\_\_\_\_ H.P. \_\_\_\_\_  
Capacity \_\_\_\_\_ G.P.M.

### WELL TESTS:

Drawdown \_\_\_\_\_ ft. after \_\_\_\_\_ hours \_\_\_\_\_ G.P.M.

Drawdown \_\_\_\_\_ ft. after \_\_\_\_\_ hours \_\_\_\_\_ G.P.M.

USE OF WATER Irrigation Temp. \_\_\_\_\_ °F. \_\_\_\_\_, 19\_\_\_\_\_

SOURCE OF INFORMATION U-873

DRILLER or DIGGER \_\_\_\_\_

### ADDITIONAL DATA:

Log X Water Level Measurements \_\_\_\_\_ Chemical Analysis \_\_\_\_\_ Aquifer Test \_\_\_\_\_

### REMARKS:

Water Level Record

OWNER: Herbert Davis OWNER'S NO. \_\_\_\_\_

Description of measuring point: Top of casing at land surface datum

Date	Water Level Feet <sup>(above)</sup> (below) Land Surface	Remarks	Date	Water Level Feet <sup>(above)</sup> (below) Land Surface	Remarks
5-6-58	30.02				
6-9-59	30.10				
12-8-59	30.78				
5-10-60	31.00				
12-13-60	31.30				
5-10-61	31.52				
12-12-61	31.82	SS RD			

REMARKS: \_\_\_\_\_  
 \_\_\_\_\_  
 \_\_\_\_\_

