

Original in WR to app # 6118 folder Harney

ORIGINAL
File Original, and
Duplicate with the
STATE ENGINEER,
SALEM, OREGON

RECEIVED
JAN 31 1956

WATER WELL DRILLERS REPORT

STATE OF OREGON

Do Not File In
Well No. 2634-6J111
State Permit No. G.29

(1) OWNER:

Name ~~Henry Fitchett~~
Address Crane, Oregon

(2) LOCATION OF WELL:

County Harney Owner's number, if any--
R. F. D. or Street No.
Bearing and distance from section or subdivision corner
1357 ft S 88° 57' E from
center of sec. 6 TWP 26 S R
34 E W. 1/4 being in NE SE said sec.

(3) TYPE OF WORK (check):

New well Deepening Reconditioning Abandon
If abandonment, describe material and procedure in Item 11.

(4) PROPOSED USE (check):

Domestic Industrial Municipal
Irrigation Test Well Other

(5) EQUIPMENT:

Rotary
Cable
Dug Well

(6) CASING INSTALLED:

Threaded Welded

If gravel packed

FROM	ft. to	ft.	Diam.	Gage or Wall	Diameter of Bore	from ft.	to ft.
Top of ground	165	"	14	8 in.			
"	"	"	"	"			
"	"	"	"	"			
"	"	"	"	"			
"	"	"	"	"			

Type and size of shoe or well ring steel

Describe joint

(7) PERFORATIONS:

Type of perforator used no perforations

SIZE of perforations in., length, by in.

FROM	ft. to	ft.	perf per foot	No. of rows
"	"	"	"	"
"	"	"	"	"
"	"	"	"	"
"	"	"	"	"

SCREENS:

Give Manufacturer's Name, Model No. and Size

(8) CONSTRUCTION:

Was a surface sanitary seal provided? Yes No To what depth ft.

Were any strata sealed against pollution? Yes No

If yes, note depth of strata

FROM	ft. to	ft.
"	"	"

METHOD OF SEALING

(9) WATER LEVELS:

Depth at which water was first found 31 to 43 ft.

Standing level before perforating ft.

Standing level after perforating ft.

Log Accepted by:

[Signed] Henry Fitchett Dated 1-27, 1956
Owner

(10) WELL TESTS: 1418

Was a pump test made? Yes No If yes, by whom? The driller

Yield:	gal./min. with	ft. draw down	ft.	hrs.
"	1000	"	15	5
"	"	"	"	"

Artesian flow g.p.m.

Shut-in pressure lbs. per square inch.

Bailer test g.p.m. with ft. drawdown

Temperature of water Was a chemical analysis made? Yes No

Was electric log made of well? Yes No

(11) WELL LOG:

Diameter of well, 14 inches.

Total depth 297 ft. Depth of completed well 297 ft.

Formation: Describe by color, character, size of material and structure, and show thickness of aquifers and the kind and nature of the material in each stratum penetrated, with at least one entry for each change of formation.

0 ft. to	1 ft.	to	ft.	Description
0	1	1	15	topsoil
1	15	15	25	brn clay with some sand
15	25	25	31	quicksand
25	31	31	43	blue shale
31	43	43	94	blue sandstone with water
43	94	94	102	blue shale with occasional streaks
94	102	102	122	brown clay with sand, gravel, & some iron
102	122	122	144	blue shale
122	144	144	146	brown clay with sand, gravel & some iron
144	146	146	165	yellow clay with sand & gravel
146	165	165	290	sand & gravel with water
165	290	290	297	cement gravel, no water
290	297	297		brown sticky clay

Ground elevation at well site 4000 feet above mean sea level.

Work started Aug 3 1955, Completed Sept. 7 1955

Well Driller's Statement:

This well was drilled under my jurisdiction and this report is true to the best of my knowledge and belief.

NAME FORREST SKINNER
(Person, firm, or corporation) (Typed or printed)

Address Ontario Rt. 2 Oregon

Driller's well number

[Signed] Forrest Skinner
(Well Driller)

License No. 45 Dated, 1956

HARN 1418

STATE ENGINEER
Salem, Oregon

Well Record

STATE WELL NO. 26/34-6J(1)
COUNTY Harney
APPLICATION NO. G-118

Harn 1418


G-6487

OWNER: Henry and Ramona Fitchett MAILING ADDRESS:

LOCATION OF WELL: Owner's No. CITY AND STATE: Crane, Oregon

NE 1/4 SE 1/4 Sec. 6 T. 26 N. S., R. 34 E. W., W.M.

Bearing and distance from section or subdivision corner S. 88° 57' E. 1357' from center of Section 6

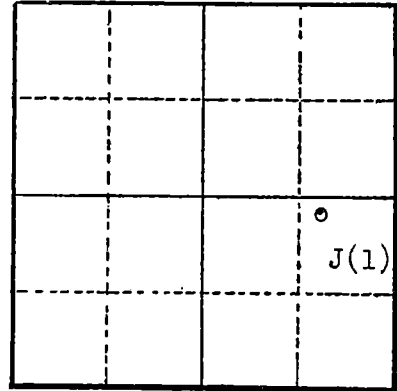

Altitude at well 4127'

TYPE OF WELL: Drilled Date Constructed Aug.-Sept. 1955

Depth drilled 297 Depth cased 165

Section 6

CASING RECORD:

14-inch set from 0 to 165 feet

FINISH:

Open hole below casing

AQUIFERS:

Sand and gravel

WATER LEVEL:

PUMPING EQUIPMENT: Type H.P.
Capacity G.P.M.

WELL TESTS:

Drawdown 15 ft. after 5 hours pumping 1,000 G.P.M.

Drawdown ft. after hours G.P.M.

USE OF WATER Irrigation Temp. °F., 19

SOURCE OF INFORMATION Well Drillers report

DRILLER or DIGGER Forest Skinner

ADDITIONAL DATA:

Log Water Level Measurements Chemical Analysis Aquifer Test

REMARKS:

