
NOTICE TO WATER WELL CONTRACTOR

The original and first copy of this report are to be filed with the

STATE ENGINEER, SALEM, OREGON 97310 within 30 days from the date of well completion.

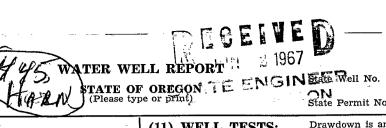

State Permit No.

(1) OWNER:	(11) WELL TESTS: Drawdown is amount water level is lowered below static level
Name J. V. Moon & Son	Was a pump test made? ☐ Yes ☒ No If yes, by whom?
Address P.O. Box 889	Yield: gal./min. with ft. drawdown after hrs.
Burns, Oregon 97720	,, ,, ,, ,, ,, ,, ,, ,, ,, ,, ,, ,, ,,
(2) LOCATION OF WELL:	" " " "
	Bailer test 100 gal./min. with 5 ft. drawdown after $1/2$ hrs.
County Harney Driller's well number 29 F.W.M. NE 34 SW34 Section 9 T. 27S R. X9XE W.M.	Artesian flow g.p.m. Date
	Temperature of water Was a chemical analysis made? ☐ Yes ☑ No
Bearing and distance from section or subdivision corner	(12) WELL LOG: Diameter of well below casing
	Depth drilled 112 ft. Depth of completed well 200 ft.
	Formation: Describe by color, character, size of material and structure, and show thickness of aquifers and the kind and nature of the material in each stratum penetrated, with at least one entry for each change of formation.
	MATERIAL FROM TO
(3) TYPE OF WORK (check):	Dark hard rock 88 138
New Well ☐ Deepening ☒ Reconditioning ☐ Abandon ☐	Mixed colored cinders w/ clay 138 154
ndonment, describe material and procedure in Item 12.	Multi-colored hard rock 154 200
(4) PROPOSED USE (check): (5) TYPE OF WELL:	
Domestic Industrial Municipal Rotary Driven Cable 🖾 Jetted	
Irrigation ☑ Test Well □ Other □ Dug □ Bored □	
(A) CACTAG TAGETA TA ED	
None	
ft. Gage ft. Gage	
ft. toft. Gage	
ft. toft. Gage	
(7) PERFORATIONS: Perforated? ☐ Yes 🖔 No	
Type of perforator used	
Size of perforations in. by in.	
perforations from ft. to ft.	
(8) SCREENS: Well screen installed? ☐ Yes ☒ No	
Manufacturer's Name	
Model No.	
i Slot size Set from ft. to ft.	Work started May 22, 1967 Completed May 31, 1967
Diam Slot size Set from ft. to ft.	Date well drilling machine moved off of well June 1, 1967
(9) CONSTRUCTION:	(13) PUMP:
Well seal—Material used in seal	
Depth of seal	Manufacturer's Name
Diameter of well bore to bottom of sealin.	Type: H.P.
Were any loose strata cemented off? Yes No Depth	Water Well Contractor's Certification:
Was a drive shoe used? ☐ Yes ☐ No	This well was drilled under my jurisdiction and this report is
Was well gravel packed? Yes No Size of gravel:	true to the best of my knowledge and belief.
Gravel placed from ft. to ft.	NAME Western Drilling Co.
Did any strata contain unusable water? ☐ Yes ☒ No	(Person, firm or corporation) (Type or print)
Type of water? depth of strata	Address P.O. Box 751 Burns, Oregon 97720
Method of sealing strata off	970
(10) WATER LEVELS:	Drilling Machine Operator's License No. 379
	[Signed] John (Illister)
Static level 20 ft. below land surface Date 5-31-6'/	(Water Well Contractor)
Artesian pressure lbs. per square inch Date	Contractor's License No. 426 Date June 1, 1961
(USE ADDITIONAL S	heets if necessary)