


RECEIVED

JUL - 3 1990

WATER RESOURCES DEPT.
SALEM, OREGON

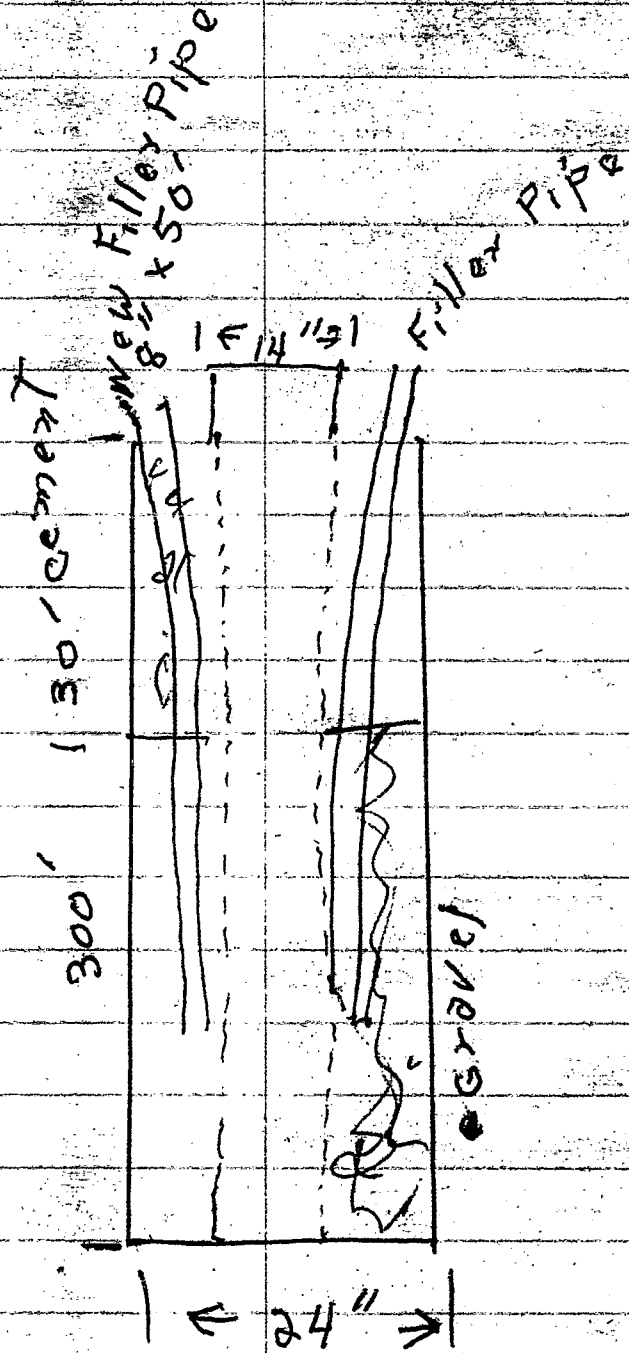

FOR WATER RESOURCES DEPARTMENT USE ONLY

Date Postmarked 4/6/90
Date Hand-delivered _____
Watermaster Initials _____

W- **14808**
WRD Receipt _____
Date Fee Received _____

White Copy

START CARD
NOTICE OF BEGINNING OF WELL CONSTRUCTION
(as required by ORS 537.762)

RECEIVED
JUN - 7 1990
WATER RESOURCES DEPT.
OREGON

This form must be completed, signed by both the owner (or authorized agent) and constructor, and the original mailed or delivered to the Water Resources Department, 3850 Portland Road NE, Salem, OR 97310, no later than the day construction, alteration, conversion or abandonment work begins. A **\$75 fee shall accompany all notices for new well construction or conversion of an existing hole not previously used as a water well** (make checks payable to the Water Resources Department). Notices meeting this requirement but received without the required fee will not be accepted as properly and timely filed. The Water Resources Commission has authority to impose civil penalties for failure to submit the required \$75 fee with the start card and for failure to submit cards prior to beginning any construction, alteration, conversion or abandonment work.

Owner's name and mailing address Coldstream Ranch
4248 Laurel Ridge Drive
Allison Park PA 15101-2132

Check type of work: New construction Repair Recondition
 Deepening Conversion Abandonment


Proposed Commencement Date June 5 1990

Existing or Proposed Well Depth 300' Diameter 14"

Check Use: Domestic Community Industrial Irrigation Monitoring
 Thermal Injection Other _____

Proposed Well Location: County Hartney

Township 24-S (N or S) Range 33 1/2 E (E or W) Section 31

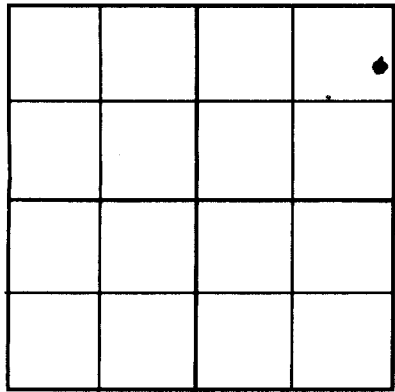

- NE 1/4 of NE 1/4 of above section
- Street address of well location Highway 78 + Sealey Rd
- Tax lot number of well location 8500 23299
- Attach map with location identified.
(See reverse of this form for approved maps)
- Show well location within 1/4, 1/4 of section grid at left.

We hereby certify that we have read the back of this form, and that to the best of our knowledge the information provided herein is accurate and the well is being properly located from septic tanks and septic drain fields.

Coldstream Ranch
Robert McCorquill
Title _____ Date 6-4-90
Home phone _____ Work phone _____

Joe Valentine
Bonded Water Well Constructor
License No. 1435
Company Valentine

NOTE: This is not a water right application. The owner is responsible for obtaining a water right through the Water Resources Department, if required.

THIS COPY TO WATER RESOURCES DEPARTMENT IN SALEM
If no fee applies, discard this copy