

STATE ENGINEER
Salem, Oregon

Well Record

STATE WELL NO. 22/32-34D(1)
COUNTY Harney
APPLICATION NO. U-611

OWNER: Robert W. Davis

MAILING
ADDRESS:


LOCATION OF WELL: Owner's No. 1

CITY AND
STATE:

Burns, Oregon

NW 1/4 NW 1/4 Sec. 34 T. 22 N. S., R. 32 E., W.M.

Bearing and distance from section or subdivision
corner S 80°42' E 967.5 ft. from NW corner
of Sec. 34, T. 22 S., R. 32 E., W.M.

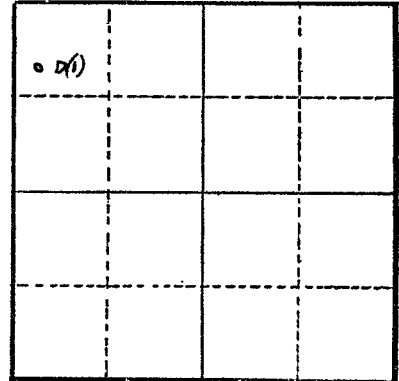

Altitude at well

TYPE OF WELL: Dug Well Date Constructed July 1959

Depth drilled 305 Depth cased

Section 34

CASING RECORD:

FINISH:

AQUIFERS:

WATER LEVEL:

11 ft. 7-53;

PUMPING EQUIPMENT: Type American Marsh Centrifugal 5" H.P.
Capacity 1500 G.P.M.

WELL TESTS:

Drawdown 1 ft. after 10 hours G.P.M.

Drawdown ft. after hours G.P.M.

USE OF WATER Irrigation Temp. °F. 19

SOURCE OF INFORMATION

DRILLER or DIGGER excavated by owner

ADDITIONAL DATA:

Log Water Level Measurements Chemical Analysis Aquifer Test

REMARKS:

STATE ENGINEER
Salem, Oregon

State Well No. 22/32-34D(1)
County Harney
Application No. U-611

Well Log

Owner: Robert W. Davis Owner's No. 1

Driller: **owner** Date Drilled **July 1953**

[illegible]