

STATE ENGINEER
Salem, Oregon

OBSERVATION WELL
Well Record

STATE WELL NO. 37/36-14A(1)
COUNTY HARNEY
APPLICATION NO.

1782
Harney

OWNER: WHITEHORSE RANCH


MAILING ADDRESS:

LOCATION OF WELL: Owner's No.

CITY AND STATE:

NE 1/4 NE 1/4 Sec. 14 T. 37 N. S. R. 36 E. W.M.

Bearing and distance from section or subdivision corner

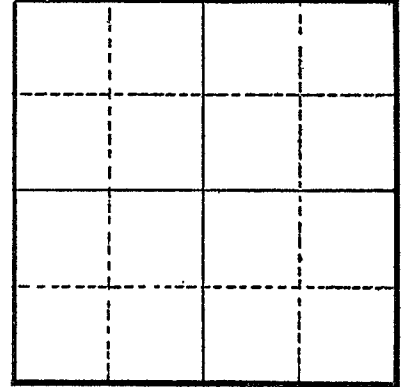

Section 14

Altitude at well

TYPE OF WELL: DRILLED Date Constructed

Depth drilled 792' Depth cased

CASING RECORD:

FINISH:

AQUIFERS:

BASALT

WATER LEVEL:

67.08 (8-21-63)

PUMPING EQUIPMENT: Type _____ H.P. _____
Capacity _____ G.P.M.

WELL TESTS:

Drawdown _____ ft. after _____ hours _____ G.P.M.
Drawdown _____ ft. after _____ hours _____ G.P.M.

USE OF WATER IRR. & Dom. Temp. _____ °F., 19
SOURCE OF INFORMATION Field Insp.

DRILLER or DIGGER

ADDITIONAL DATA:

Log NA Water Level Measurements Chemical Analysis _____ Aquifer Test _____

REMARKS: