
NOTICE TO WATER WELL CONTRACTOR The original and first copy of this report are to be filed with the

Gravel placed from ft. to ft.

HARN 226

STATE OF OREGON

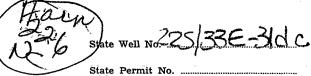

W.M.

To

20

47 58

WATER RESOURCES DEPARTIENT SALEM, OREGON 97310 within 30 days from the date SEP 2 8 1977(Do not write above this line) of well completion. WATER RESOURCES DEPT. (10) LOCATION OF WELL: (1) OWNER: SALEM, OREGON Name Lost Spring Ranch Driller's well number 67-77-7 County Harney S.R. 2-15141 -Hwy. 20 SW 14 SE 14 Section 31 T. 22S R. 33E Burns, Oregon 97720 Bearing and distance from section or subdivision corner (2) TYPE OF WORK (check): New Well Deepening [Reconditioning [Abandon 🗌 If abandonment, describe material and procedure in Item 12. (11) WATER LEVEL: Completed well. (3) TYPE OF WELL: (4) PROPOSED USE (check): Depth at which water was first found Rotary Driven | Domestic | Industrial | Municipal | Static level ft. below land surface. Date 7-4-77 Jetted 🔲 Cable Irrigation K Test Well | Other Bored | Artesian pressure lbs, per square inch. Date (5) CASING INSTALLED: Threaded [Welded M (12) WELL LOG: Diameter of well below casing 12 _____16..." Diam. from __2! 9!! ___t. to _____89... ft. Gage ____250... 215 Depth drilled ft. Depth of completed well" Diam. from ft. to ft. Gage Formation: Describe color, texture, grain size and structure of materials: ..." Diam. from ft. to ft. Gage and show thickness and nature of each stratum and aquifer penetrated, with at least one entry for each change of formation. Report each change in position of Static Water Level and indicate principal water-bearing strata. (6) PERFORATIONS: Perforated? Yes A No. Type of perforator used MATERIAL From Size of perforations in. by 0 Top soil _____ ft. to _____ ft. Clay Brown ft. to ft. Clay Brown Sandy 20 perforations from Clay Brown (7) SCREENS: Well screen installed? | Yes No Manufacturer's Name Model No. Diam. Slot size Set from ft. to ft. Diam. Slot size Set from ft. to ft. (8) WELL TESTS: Drawdown is amount water level is lowered below static level Was a pump test made? ☐ Yes ▼ No If yes, by whom? gal./min. with ft. drawdown after ,, " Bailer test 100 gal./min. with 58 ft. drawdown after 1 hrs. Artesian flow perature of water 52 Depth artesian flow encountered ft. (9) CONSTRUCTION: Well seal-Material used Bentonite Number of sacks of eement used in well seal How was soment grout placed? Brand mand of Was a drive shoe used?

Yes
No Plugs Size: location ft. Did any strata contain unusable water? 🗌 Yes 🐒 No Type of water? depth of strata Method of sealing strata off Was well gravel packed? [] Yes Z No Size of gravel:

	Clay Brown Sandy	- 58	- 88			
	Lava Rock Coarse Sand	- 88	100			
	Clay Light Brown	100	_110_			
	Clay Blue	110	140			
	Sand Black	140	142			
	Clay Blue	142	160			
	Lava Rock Coarse Blue	160	165			
	Lava Rock Coarse Sandy Breen	165	170			
	Clay Green Sandy	170	185			
	Clay Green	185	200			
	Clay Green Sticky	200	210			
	Clay Green	210	215			
			- , ,			
	<u> </u>					
	Work started 7-2 19 77 Complete	d E	-29	19 77		
	Date well drilling machine moved off of well	. ε	-29	19 77		
•	Drilling Machine Operator's Certification: This well was constructed under my Materials used and information reported best knowledge and belief. [Signed] (Drilling Machine Operator's License No.	above	are true	to my		
	Water Well Contractor's Certification:					
	This well was drilled under my jurisdiction and this report is true to the best of my knowledge and belief.					
	Name Bob Scheler Drilling (Person, firm or corporation)	(T ₃	pe or prin	nt)		
	Address405 N. BurkhattAlbany, Oregon97321					
	[Signed] Bob Scholer (Water Well Contr	actor)	••••			
			1 .			
1	~	7	12/	ソフ		
-	Contractor's License No610 Date	<u>1</u>	126	, 19.7.7		
H	Contractor's License No6.10 Date EETS IF NECESSARY)	1		., 19.7.7 P*45656-119		



Oregon Water Resources Department 725 Summer Street NE, Suite A Salem Oregon 97301 (503) 986-0900 www. oregon.gov/owrd

Application for Well ID Number

RECEIVED

Do not complete if the well alre	ady has a Well Identi	ification Number.
----------------------------------	-----------------------	-------------------

APR 2 5 2019

OWRD		OWRD	
I. OWNER INFORMATION			
Current Owner Name (please print): Andy Root	<u>t</u>		
Mailing Address: 524 Hwy 20 N			
City, State, Zip: Hines, OR 97738			
Mail Well ID to: SAME AS ABOV	E In Care Of (C/O)	
Name & Address: All Points Engr & Surveying	ng, Inc, PO Box 767	·	
City, State, Zip: Terrebonne, OR 97760			
II. <u>WELL LOCATION INFORMATION</u> (Pleat Township: 22S (North / South) Range: 33		•	1/4
Tax Lot (usually last 3-5 numbers of Tax Map #):		County Harney	- 1/4
GPS Coordinates: 43.611687000 - 118.6931		County Harries	
Street Address of Well, City: 40637 Hwy 20 E	Burns OR		
Street Address of Well, City: 1999 1117			
If the property had a different street address in the	past:		
III. GENERAL WELL INFORMATION (Pleated by the second secon	use fill out as completely as possib dustrial, monitoring): Irrigation 77 Total Well Depth:	ole, AND attach copy of Well Report, if availated. 215 Casing Diameter: 16"	·








Last Update: 5/15/18 Well I.D. Number/2 WCC



114930 1057! Application for Repl: 134029

Well ID Number

Do not complete if the well already has a Well Identification Number.		RECEIVED BY OWRD		
x y	Do not complete if the well direday has a Well Identification Number.		JUN 03	2014
I. OWNER INFORMATION			0.1 1 ==	
	Current Owner Name (please print): Bo Thorenfeldt			OR
Mailing Address: 888 Hillsborough Blvd				
City, State, Zip: Hillsborough, CA 94010				
Mail Well ID Tag to: SAME AS A	ABOVE ✓ In Care Of (0	C/O)		
Name & Address: Eric Bauer				
City, State, Zip: 40637 Hwy 20	E, Burns, Or 9	1720		
II. WELL LOCATION INFORMAT	ION (Please fill out as complet	ely as possible)		
Township: 22S (North / Sou	th) Range: 33E	(East / West)	Section: 31	
Tax Lot: <u> </u>		Sw	_{1/4} SE	1/4
GPS Coordinates:				
Street Address of Well, City: Hwy	120 (off of) B	urns		
Use of Well (domestic, irrigation, commercia Date Well Constructed (or property built): 9/	l, industrial, monitoring): Irrig	ation	Casing Diameter:	16"
Owner at time the well was constructed (if kn Other Information: HARN 226				
SUBMITTED BY (please print): Denise M	ontgomery			
PHONE: 541-548-5833	EMAIL &/or FAX: need	cee@apeands.com	1	
Send application to: Oregon Water Resources 0902. Applications are processed in the order	Department 725 Summer St Note they are received, and Well ID	E, Suite A, Salem, O Numbers are mailed	regon 97301; or fax to (d within 4-5 business day	503) 986- ⁄s.
For Official	Use Only by the Oregon Water	Resources Departm	ent:	
Received Date:	Well Log Numb	er:	Well Identi	fication #:
6-3-14	HARN 2	26	1-H	1936
			10-51	1 64

Last Update: 4/30/14

Well I.D. Number/2