

STATE ENGINEER
Salem, Oregon

OBSERVATION WELL

Harney
271

Well Record

STATE WELL NO. 23/27-30B(1)
COUNTY Harney
APPLICATION NO. G-309

(GREEN VALLEY RANCH)


see deepening log

OWNER: Clifton R. Breniman - Farm Development Co. MAILING ADDRESS: _____

LOCATION OF WELL: Owner's No. _____ CITY AND STATE: Riley, Oregon

NW 1/4 NE 1/4 Sec. 30 T. 23 S., R. 27 W., W.M.

Bearing and distance from section or subdivision corner 400' S. & 1240' W. of SW corner, Sec. 19

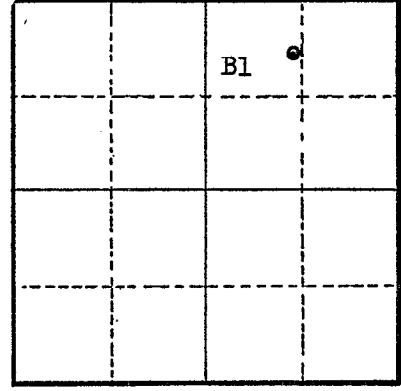

Section 30

Altitude at well _____

TYPE OF WELL: Drilled Date Constructed 1952

Depth drilled 268 Depth cased 268

CASING RECORD:

24-inch

FINISH:

AQUIFERS:

WATER LEVEL:

42 feet below land surface, 9-23-58

PUMPING EQUIPMENT: Type Turbine H.P. _____
Capacity _____ G.P.M.

WELL TESTS:

Drawdown _____ ft. after _____ hours _____ G.P.M.
Drawdown _____ ft. after _____ hours _____ G.P.M.

USE OF WATER Irrigation Temp. _____ °F. _____, 19_____

SOURCE OF INFORMATION G-309

DRILLER or DIGGER CAL BRAM

ADDITIONAL DATA:

Log _____ Water Level Measurements _____ Chemical Analysis _____ Aquifer Test _____

REMARKS: