

STATE ENGINEER
Salem, Oregon

Handwritten: Burn 284

Well Record


STATE WELL NO. 23/30-12J(1)
COUNTY Harney
APPLICATION NO. G-1490

OWNER: City of Burns MAILING ADDRESS: _____

LOCATION OF WELL: Owner's No. 1 CITY AND STATE: Burns, Oregon

NE 1/4 SE 1/4 Sec. 12 T. 23 N. S., R. 30 W., W.M.

Bearing and distance from section or subdivision corner 241' S. & 979' West from E 1/4 cor

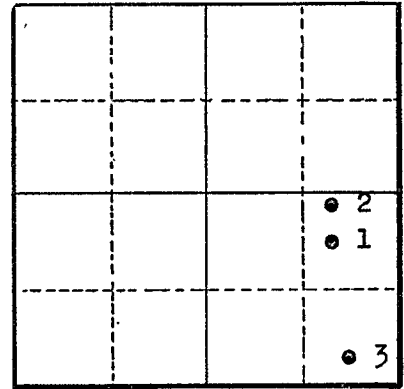

Section 12

Altitude at well _____

TYPE OF WELL: Drilled Date Constructed _____

Depth drilled 251 Depth cased 100

CASING RECORD:
12-inch

FINISH:

AQUIFERS:

WATER LEVEL:

85

PUMPING EQUIPMENT: Type Turbine H.P. 50
Capacity 800 G.P.M. 1.85 c.f.s.

WELL TESTS:

Drawdown _____ ft. after _____ hours _____ G.P.M.
Drawdown _____ ft. after _____ hours _____ G.P.M.

USE OF WATER Public supply Temp. 57 °F., 19
SOURCE OF INFORMATION G-1490 Well 17 WSP 841

DRILLER or DIGGER _____

ADDITIONAL DATA:
Log _____ Water Level Measurements _____ Chemical Analysis _____ Aquifer Test _____

REMARKS: