

STATE ENGINEER
Salem, Oregon

Harney
288

Well Record

STATE WELL NO. 23/30-12R(1)
COUNTY Harney
APPLICATION NO. G-1490

OWNER: City of Burns MAILING ADDRESS: _____

LOCATION OF WELL: Owner's No. 3 CITY AND STATE: Burns, Oregon


SE $\frac{1}{4}$ SE $\frac{1}{4}$ Sec. 12 T. 23 S., R. 30 W., W.M.

Bearing and distance from section or subdivision
corner 292' N. & 475' W. from SE cor. of Sec.

Altitude at well _____

TYPE OF WELL: Drilled Date Constructed _____

Depth drilled 304 Depth cased 85

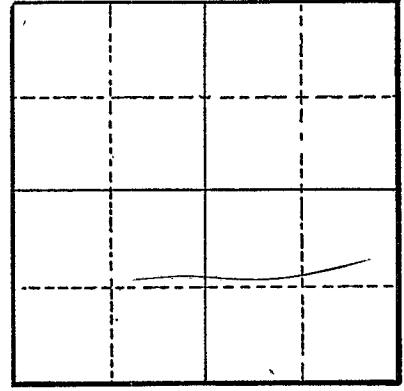

Section _____

CASING RECORD:

16-inch

FINISH:

AQUIFERS:

WATER LEVEL:

12 feet below LSD

PUMPING EQUIPMENT: Type Turbine H.P. 100
Capacity _____ G.P.M.

WELL TESTS:

Drawdown _____ ft. after _____ hours _____ G.P.M.
Drawdown _____ ft. after _____ hours _____ G.P.M.

USE OF WATER public supply Temp. _____ °F. _____, 19_____

SOURCE OF INFORMATION G-1490

DRILLER or DIGGER _____

ADDITIONAL DATA:

Log _____ Water Level Measurements _____ Chemical Analysis _____ Aquifer Test _____

REMARKS: