

STATE ENGINEER
Salem, Oregon

Ham
301

Well Record

STATE WELL NO. 23/30-23H(1)
COUNTY
APPLICATION NO.

OWNER: Stafford, Derbes & Roy Co.


MAILING ADDRESS:

LOCATION OF WELL: Owner's No.

CITY AND STATE:

NE 1/4 SE 1/4 Sec. 23 T. 23 S., R. 30 N. W., W.M.

Bearing and distance from section or subdivision corner

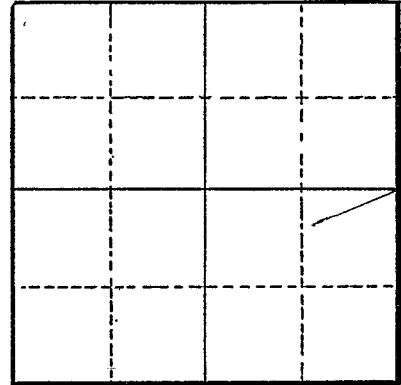

Section

Altitude at well 4159'

TYPE OF WELL: Date Constructed

Depth drilled 170' Depth cased 100' ±

CASING RECORD:

6-inch diameter

FINISH:

AQUIFERS:

WATER LEVEL:

PUMPING EQUIPMENT: Type H.P.
Capacity G.P.M.

WELL TESTS:

Drawdown ft. after hours G.P.M.
Drawdown ft. after hours G.P.M.

USE OF WATER public service Temp. °F., 19.....

SOURCE OF INFORMATION Well #21 WSP 841

DRILLER or DIGGER

ADDITIONAL DATA:

Log Water Level Measurements Chemical Analysis Aquifer Test

REMARKS: