

STATE ENGINEER  
Salem, Oregon

# Well Record

STATE WELL NO. 23/30-26J(1)  
COUNTY Harney  
APPLICATION NO. U-29


Harney  
313

OWNER: Edward Hines Lumber Co. MAILING ADDRESS: \_\_\_\_\_

LOCATION OF WELL: Owner's No. #1 CITY AND STATE: Burns, Oregon

NE 1/4 SE 1/4 Sec. 26 T. 23 S., R. 30 W, W.M.

Bearing and distance from section or subdivision corner \_\_\_\_\_

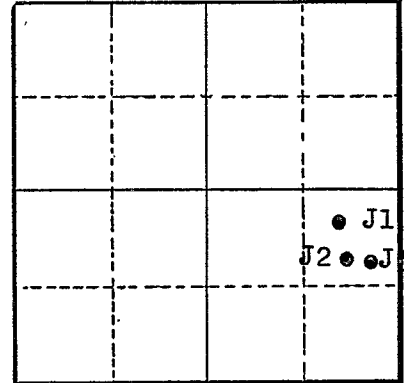

Section \_\_\_\_\_

Altitude at well 4147

TYPE OF WELL: Drilled Date Constructed \_\_\_\_\_

Depth drilled 78 Depth cased \_\_\_\_\_

### CASING RECORD:

Drilled to 78' backfilled to 53'  
18-inch casing

### FINISH:

### AQUIFERS:

alluvium

### WATER LEVEL:

PUMPING EQUIPMENT: Type Turbine H.P. \_\_\_\_\_  
Capacity 35-60 G.P.M.

### WELL TESTS:

Drawdown \_\_\_\_\_ ft. after \_\_\_\_\_ hours \_\_\_\_\_ G.P.M.  
Drawdown \_\_\_\_\_ ft. after \_\_\_\_\_ hours \_\_\_\_\_ G.P.M.

USE OF WATER Industrial Temp. \_\_\_\_\_ °F., 19 \_\_\_\_\_

SOURCE OF INFORMATION U-29 WSP 841

DRILLER or DIGGER \_\_\_\_\_

### ADDITIONAL DATA:

Log \_\_\_\_\_ Water Level Measurements \_\_\_\_\_ Chemical Analysis \_\_\_\_\_ Aquifer Test \_\_\_\_\_

### REMARKS:

Well 26 in WSP 841