

STATE ENGINEER
Salem, Oregon

Harney
314

Well Record

STATE WELL NO. 23/30-26J(2)
COUNTY Harney
APPLICATION NO. U-29

OWNER: Hines Lumber Co.


MAILING ADDRESS:

LOCATION OF WELL: Owner's No. _____

CITY AND STATE: Burns, Oregon

NE 1/4 SE 1/4 Sec. 26 T. 23 N. S., R. 30 E. W., W.M.

Bearing and distance from section or subdivision corner _____

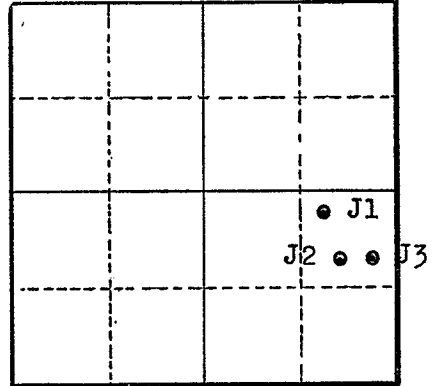

Section 26

Altitude at well _____

TYPE OF WELL: Drilled Date Constructed _____

Depth drilled 154 Depth cased _____

CASING RECORD:

12-inch

FINISH:

AQUIFERS:

WATER LEVEL:

PUMPING EQUIPMENT: Type Turbine H.P. 40
Capacity 1,000 G.P.M.

WELL TESTS:
Drawdown 7 ft. after _____ hours pumping 500 G.P.M.
Drawdown _____ ft. after _____ hours _____ G.P.M.

USE OF WATER Industrial Temp. _____ °F., 19 _____

SOURCE OF INFORMATION U-29 WSP 841

DRILLER or DIGGER _____

ADDITIONAL DATA:
Log _____ Water Level Measurements _____ Chemical Analysis _____ Aquifer Test _____

REMARKS:

Well 25 in WSP 841