

STATE ENGINEER
Salem, Oregon

Harney
315

Well Record

STATE WELL NO. 23/30-26J(3)
COUNTY Harney
APPLICATION NO. U-29

OWNER: Edward Hines Lumber Co.

MAILING ADDRESS:


LOCATION OF WELL: Owner's No. #3

CITY AND STATE:

Burns, Oregon

NE $\frac{1}{4}$ SE $\frac{1}{4}$ Sec. 26 T. 23 S., R. 30 W., W.M.

Bearing and distance from section or subdivision corner

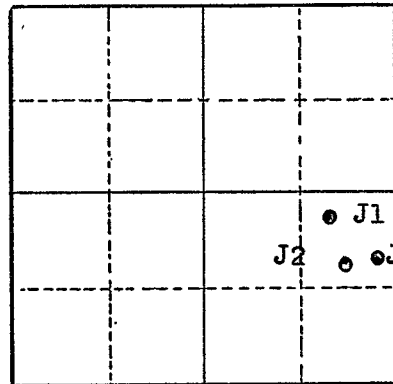

Section 26

Altitude at well

TYPE OF WELL: Drilled Date Constructed

Depth drilled 173 Depth cased

CASING RECORD:

12-inch, set to 100 feet

FINISH:

AQUIFERS:

WATER LEVEL:

PUMPING EQUIPMENT: Type Turbine H.P. 40
Capacity 1,000 G.P.M.

WELL TESTS:

Drawdown ft. after hours G.P.M.
Drawdown ft. after hours G.P.M.

USE OF WATER Industrial Temp. °F., 19

SOURCE OF INFORMATION U-29 WSP 841

DRILLER or DIGGER

ADDITIONAL DATA:

Log Water Level Measurements Chemical Analysis Aquifer Test

REMARKS:

Well #24 in WSP 841
Well flowed 100 gpm when drilled