

STATE ENGINEER
Salem, Oregon

*Harney
329*

Well Record

STATE WELL NO. 23/31-1N(1)
COUNTY Harney
APPLICATION NO. _____

OWNER: Davidson MAILING ADDRESS: _____

LOCATION OF WELL: Owner's No. _____ CITY AND STATE: _____


SW 1/4 SW 1/4 Sec. 1 T. 23 S. R. 31 W., W.M.

Bearing and distance from section or subdivision corner _____

Altitude at well _____

TYPE OF WELL: Drilled Date Constructed _____

Depth drilled 400 Depth cased _____

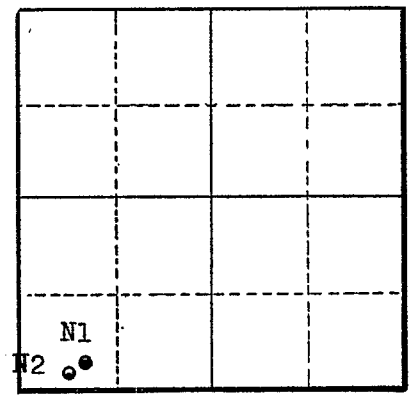

Section 1

CASING RECORD:

8-inch

FINISH:

AQUIFERS:

WATER LEVEL:

See water level measurements

PUMPING EQUIPMENT: Type Piston, windmill H.P. _____
Capacity _____ G.P.M.

WELL TESTS:

Drawdown _____ ft. after _____ hours _____ G.P.M.
Drawdown _____ ft. after _____ hours _____ G.P.M.

USE OF WATER none Temp. _____ °F. _____, 19____

SOURCE OF INFORMATION #30 WSP 841

DRILLER or DIGGER _____

ADDITIONAL DATA:

Log _____ Water Level Measurements Chemical Analysis _____ Aquifer Test _____

REMARKS:

measured depth was 63' in 1930

STATE ENGINEER
Salem, Oregon

State Well No. 23/31-1N(1)

County Harney

Application No. _____

Water Level Record

OWNER: - Davidson OWNER'S NO. _____

Description of measuring point: Top of casing 8.40 ft below L.S.D.

Well #30 WSP 841

LSD = 4142.60

Date	Water Level Feet (below) Land Surface	Remarks	Date	Water Level Feet (above) (below) Land Surface	Remarks
8-23-30	14.0				
5-12-31	13.10				
5-18-31	13.35				
6-1-31	14.12				
6-8-31	14.46				
6-22-31	14.72				
7-6-31	15.31				
7-20-31	15.64				
7-27-31	15.94				
8-3-31	15.90				
8-10-31	15.31				
8-17-31	15.33				
8-24-31	14.75				
9-7-31	14.04				
9-14-31	13.72				
10-14-31	13.40				
10-19-31	13.40				
5-12-32	11.30				

REMARKS: _____

