

STATE ENGINEER  
Salem, Oregon

# Well Record

STATE WELL NO. 23/31-15B(3)  
COUNTY Harney  
APPLICATION NO. U-22

Area 461

OWNER: Will M. McLaren

MAILING  
ADDRESS:


LOCATION OF WELL: Owner's No. \_\_\_\_\_

CITY AND  
STATE:

Burns, Oregon

NW  $\frac{1}{4}$  NE  $\frac{1}{4}$  Sec. 15 T. 23 S., R. 31  $\frac{N}{W}$ , W.M.

Bearing and distance from section or subdivision  
corner \_\_\_\_\_

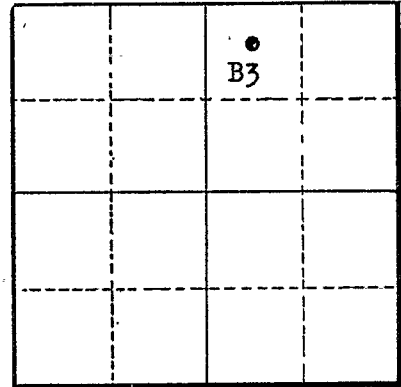

Section 15

Altitude at well 4142

TYPE OF WELL: \_\_\_\_\_ Date Constructed 1930

Depth drilled 72 Depth cased \_\_\_\_\_

### CASING RECORD:

18-inch, set to 53 feet  
Perforated from 41 to 53 feet

### FINISH:

### AQUIFERS:

### WATER LEVEL:

PUMPING EQUIPMENT: Type \_\_\_\_\_ H.P. 15  
Capacity \_\_\_\_\_ G.P.M.

### WELL TESTS:

Drawdown \_\_\_\_\_ ft. after \_\_\_\_\_ hours \_\_\_\_\_ G.P.M.  
Drawdown \_\_\_\_\_ ft. after \_\_\_\_\_ hours \_\_\_\_\_ G.P.M.

USE OF WATER Irrigation Temp. \_\_\_\_\_ °F., 19 \_\_\_\_\_

SOURCE OF INFORMATION WSP 841

DRILLER or DIGGER P. S. Weitenhiller

### ADDITIONAL DATA:

Log  Water Level Measurements  Chemical Analysis \_\_\_\_\_ Aquifer Test \_\_\_\_\_

### REMARKS:

Tested at 480 gpm

41



STATE ENGINEER  
Salem, Oregon

State Well No. <sup>15</sup> 23/31-~~A~~B(3)

County HARNEY

Application No. U 22

### Water Level Record

OWNER: Wm. Mc Laren OWNER'S NO.

Description of measuring point: Bottom of 1/2" hole on side of casing, 0.1' above  
LSD

Well # 64 W58 841 LSD = 4141 82

Date	Water Level Feet (above) (below) Land Surface	Remarks	Date	Water Level Feet (above) (below) Land Surface	Remarks
8-9-30	8.15			5-18-31	8.55
8-12-30	8.45			5-23-31	9.35
9-6-30	8.60			6-1-31	11.61
10-4-30	8.75			6-15-31	11.63
10-18-30	8.60			8-10-31	11.28
11-1-30	8.80			8-17-31	9.23
12-7-30	8.85			8-24-31	9.15
1-3-31	8.90			8-31-31	9.10
2-8-31	8.90			9-7-31	9.62
3-8-31	8.90		9-14-31	9.18	
2-16-31	8.98		9-20-31	9.19	
2-25-31	8.54		9-28-31	9.15	
3-31-31	8.52		10-5-31	9.14	
4-5-31	8.52		10-14-31	9.09	
4-11-31	8.37		10-19-31	9.10	
4-20-31	8.29		10-26-31	9.09	
4-29-31	8.27		11-10-31	9.07	
5-9-31	8.77		12-6-31	9.04	

REMARKS:

STATE ENGINEER  
Salem, Oregon

State Well No. 23/31-15B(3)

County HARNEY

Application No. 0-22

### Water Level Record

OWNER: Wm McLaren OWNER'S NO. \_\_\_\_\_

Description of measuring point: \_\_\_\_\_

Well 64 in WSP 841

414182

Date	Water Level Feet (above (below) Land Surface	Remarks	Date	Water Level Feet (above (below) Land Surface	Remarks
1-6-32	9.09				
2-3-32	9.17				
2-4-32	8.83				
3-19-32	8.64				
3-26-32	8.72				
4-2-32	4.30				
4-9-32	3.44				
4-16-32	2.76				
4-23-32	3.35				
4-30-32	2.04				
5-7-32	1.80				
5-14-32	1.99				
5-23-32	2.43				
6-7-32	2.40				
7-6-32	5.37				
7-19-32	6.44	41			
4-22-26	2.12	4129.7 WSP 817			

REMARKS: \_\_\_\_\_