

STATE ENGINEER
Salem, Oregon

Well Record

STATE WELL NO. 23/31-18K(1)
COUNTY Harney
APPLICATION NO. G-197


Harney 481

OWNER: J. C. Clemens MAILING ADDRESS: Box 768

LOCATION OF WELL: Owner's No. #1 CITY AND STATE: Burns, Oregon

NW 1/4 SE 1/4 Sec. 18 T. 23 S., R. 31 W., W.M.

Bearing and distance from section or subdivision corner 130 feet east and 30 feet south
from center of Section 18

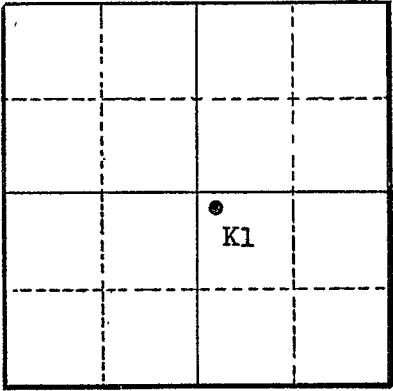

Section 18

Altitude at well _____

TYPE OF WELL: Drilled Date Constructed _____

Depth drilled 72 Depth cased 62

CASING RECORD:

12 inch set from 0 to 62 feet

FINISH:

Perforations from 27 to 34 feet and from 45 to 58 feet

AQUIFERS:

Gravel from 31 to 34, 45 to 53 and 70 to 72 feet.

WATER LEVEL:

2 feet below land surface

PUMPING EQUIPMENT: Type _____ H.P. _____
Capacity _____ G.P.M.

WELL TESTS:

Drawdown 40 ft. after 5 hours pumping 1000 G.P.M.
Drawdown _____ ft. after _____ hours _____ G.P.M.

USE OF WATER Irrigation Temp. _____ °F., 19 _____
SOURCE OF INFORMATION Well Drillers Report

DRILLER or DIGGER Jack McClure

ADDITIONAL DATA:

Log Water Level Measurements _____ Chemical Analysis _____ Aquifer Test _____

REMARKS:

