

HARN  
SOSIA

RECEIVED  
HARN 50519  
MAY 11 2000

STATE OF OREGON  
WATER SUPPLY WELL REPORT  
(as required by ORS 537.765)

WATER RESOURCES DEPT.  
SALEM, OREGON

WELL I.D. # L38709  
START CARD # W116932

Instructions for completing this report are on the last page of this form.

(1) OWNER: Dan wells Well Number \_\_\_\_\_

Name Dan wells  
Address 10201 SW Lyons Dr  
City Clatsop State Ore Zip 97134

(2) TYPE OF WORK  
 New Well  Deepening  Alteration (repair/recondition)  Abandonment

(3) DRILL METHOD:  
 Rotary Air  Rotary Mud  Cable  Auger  
 Other

(4) PROPOSED USE:  
 Domestic  Community  Industrial  Irrigation  
 Thermal  Injection  Livestock  Other Test

(5) BORE HOLE CONSTRUCTION:  
Special Construction approval  Yes  No Depth of Completed Well 200 ft.  
Explosives used  Yes  No Type \_\_\_\_\_ Amount \_\_\_\_\_

HOLE		SEAL				
Diameter	From To	Material	From To	Sacks or pounds		
16	0 34	Best Seal	34 0	22 Sacks		
12	34 200	-	-	-		
10	200 205	-	-	-		

How was seal placed: Method  A  B  C  D  E  
 Other Air Inject  
Backfill placed from \_\_\_\_\_ ft. to \_\_\_\_\_ ft. Material \_\_\_\_\_  
Gravel placed from \_\_\_\_\_ ft. to \_\_\_\_\_ ft. Size of gravel \_\_\_\_\_

(6) CASING/LINER:

Diameter	From	To	Gauge	Steel	Plastic	Welded	Threaded
Casing: 12	42	95	.250	<input checked="" type="checkbox"/>	<input type="checkbox"/>	<input checked="" type="checkbox"/>	<input type="checkbox"/>
Liner:				<input type="checkbox"/>	<input type="checkbox"/>	<input type="checkbox"/>	<input type="checkbox"/>

(7) PERFORATIONS/SCREENS:

Perforations Method NO  
 Screens Type \_\_\_\_\_ Material \_\_\_\_\_

From	To	Slot size	Number	Diameter	Tele/pipe size	Casing	Liner
						<input type="checkbox"/>	<input type="checkbox"/>
						<input type="checkbox"/>	<input type="checkbox"/>
						<input type="checkbox"/>	<input type="checkbox"/>
						<input type="checkbox"/>	<input type="checkbox"/>

(9) LOCATION OF WELL by legal description:  
County Haney Latitude \_\_\_\_\_ Longitude \_\_\_\_\_  
Township 23 S N or S Range 33 E E or W. WM.  
Section 4 NW 1/4 SW 1/4  
Tax Lot 500 Lot \_\_\_\_\_ Block \_\_\_\_\_ Subdivision \_\_\_\_\_  
Street Address of Well (or nearest address) 1 Mile South on Primary La. Buchanan Ore.

(10) STATIC WATER LEVEL:  
5 ft. below land surface. Date 5-6-00  
Artesian pressure \_\_\_\_\_ lb. per square inch. Date \_\_\_\_\_

(11) WATER BEARING ZONES:  
Depth at which water was first found \_\_\_\_\_

From	To	Estimated Flow Rate	SWL
95	110	100 +	5
180	195	100 +	5

(12) WELL LOG:  
Ground Elevation \_\_\_\_\_

Material	From	To	SWL
Top Soil	0	6	-
Brown Clay	6	24	-
Brown Sand	24	34	-
Gravel	34	42	-
Blue & Green Clay Stone	42	95	-
Washed Gravel & Vesicular			
Brown Basalt	95	110	5
Brown & white Clay Stone	110	180	5
Vesicular Brown & Black Basalt	180	195	5
Medium Brown Basalt	195	205	5

Date started 5-2-00 Completed 5-6-00

(unbonded) Water Well Constructor Certification:  
I certify that the work I performed on the construction, alteration, or abandonment of this well is in compliance with Oregon water supply well construction standards. Materials used and information reported above are true to the best of my knowledge and belief.

WWC Number \_\_\_\_\_  
Signed \_\_\_\_\_ Date \_\_\_\_\_

(bonded) Water Well Constructor Certification:  
I accept responsibility for the construction, alteration, or abandonment work performed on this well during the construction dates reported above. All work performed during this time is in compliance with Oregon water supply well construction standards. This report is true to the best of my knowledge and belief.

WWC Number 1521  
Signed Ronald D. Lead Date 5-6-00

RECEIVED  
SEP 13 2000


WATER RESOURCES DEPT.  
SALEM, OREGON

Minimum testing time is 1 hour  
 Pump  Bailer  Air  Artesian  
Yield gal/min 100+ Drawdown 200 Drill stem at 205 Time 2 1/2 hr.  
Temperature of water 61 Depth Artesian Flow Found \_\_\_\_\_  
Was a water analysis done NO  Yes By whom \_\_\_\_\_  
Did any strata contain water not suitable for intended use? NO  Too little  
 Salty  Muddy  Odor  Colored  Other \_\_\_\_\_  
Depth of strata: \_\_\_\_\_

WELL LOCATION - 30' N, 30' W FROM THE  
E 1/4 COR. SEC. 2, T 27 S, R 30 E, WM

**PROVISIONAL MAP**  
Produced from original  
manuscript drawings. Infor-  
mation shown as of date of  
field check.

THIS MAP COMPIRES WITH NATIONAL MAP ACCURACY STANDARDS  
FOR SCALE BY U.S. GEOLOGICAL SURVEY  
DENVER, COLORADO 80225, OR RESTON, VIRGINIA 22092

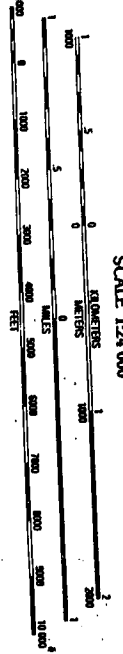

ADJOINING 7.5 QUADRANGLE MAPS

1	2	3
4	5	6
7	8	

- ROAD LEGEND**
- Improved Road
  - Unimproved Road
  - Trail
  - Interstate Route
  - U.S. Route
  - State Route

**THE NARROWS, OREGON**  
PROVISIONAL EDITION 1990  
43118-C8-1F-024

MAR 1 2000

RECEIVED

WATER RESOURCES DEPT.  
SALEM, OREGON

MAY 1 1 2000

RECEIVED

WATER RESOURCES DEPT.  
SALEM, OREGON

RECEIVED

SEP 13 2000

WATER RESOURCES DEPT.  
SALEM, OREGON

3-DIGITIZED SURVEY  
1990 AND 1991  
1992  
1993  
