

SEP 25 2000

STATE OF OREGON WATER SUPPLY WELL REPORT WATER RESOURCES DEPT. SALEM, OREGON

WELL I.D. # L39239 START CARD # 130089

Instructions for completing this report are on the last page of this form.

(1) OWNER: Floyd Garland, Well Number, Address 398 N Broadway, City Burns, State OR, Zip 97720

(2) TYPE OF WORK: New Well, Deepening, Alteration, Abandonment

(3) DRILL METHOD: Rotary Air, Rotary Mud, Cable, Auger, Other

(4) PROPOSED USE: Domestic, Community, Industrial, Irrigation, Thermal, Injection, Livestock, Other

(5) BORE HOLE CONSTRUCTION: Special Construction approval, Explosives used, Depth of Completed Well 405 ft.

Table with columns: HOLE Diameter, SEAL From, To, Material, From, To, Sacks or pounds. Includes bentonite seal data.

How was seal placed: Method A, B, C, D, E. Other poured dry and tamped. Backfill placed from, Gravel placed from.

(6) CASING/LINER: Table with columns: Diameter, From, To, Gauge, Steel, Plastic, Welded, Threaded. Includes casing and liner data.

Final location of shoe(s)

(7) PERFORATIONS/SCREENS: Table with columns: From, To, Slot size, Number, Diameter, Material, Tele/pipe size, Casing, Liner.

(8) WELL TESTS: Minimum testing time is 1 hour. Pump, Bailer, Air, Flowing Artesian. Yield gal/min, Drawdown, Drill stem at, Time.

(9) LOCATION OF WELL by legal description: County Harney, Township 23S, Range 30E, Section 14, Lot 800, Block, Subdivision, Street Address King Ave, Garland Estates

(10) STATIC WATER LEVEL: 375 ft. below land surface, Date 9-18-00, Artesian pressure lb. per square inch, Date

(11) WATER BEARING ZONES: Depth at which water was first found 380

Table with columns: From, To, Estimated Flow Rate, SWL. Includes data for 380 to 403 ft.

(12) WELL LOG: Ground Elevation

Table with columns: Material, From, To, SWL. Includes sandy loam topsoil, sandstone, rock, cinders, clay, etc.

Date started 8-21-00, Completed 9-18-00

(unbonded) Water Well Constructor Certification: I certify that the work I performed... Signed Date

(bonded) Water Well Constructor Certification: I accept responsibility for the construction... Signed Timothy K. Riley Date 9-21-00

Date Postmarked 8-22-00
Date Hand-Delivered _____
Watermaster Initials _____

W 130087
WRD Receipt 39906
Date Fee Received 8-24-00
Check No. 3891

START CARD

NOTICE OF BEGINNING OF WELL CONSTRUCTION

(as required by ORS 537.762)

This form must be completed and the original copy mailed or delivered to the Water Resources Department, 158 12th St. NE, Salem, OR 97310, for all new well construction, or conversion of an existing hole not previously used to seek water. This original copy must be mailed or delivered no later than the day construction or conversion work begins. A \$75 fee shall accompany the original copy for all new well construction and conversion (make checks payable to the Water Resources Department). Notices meeting the submittal requirements but received without the required fee will not be accepted as properly and timely filed. In addition, the constructor shall provide the "Watermaster Copy" of this notice to the office of the district watermaster within which the well is being constructed, altered, converted or abandoned using one of the following options: (a) by regular mail no later than three (3) calendar days (72 hours) prior to commencement of work; or, (b) by hand delivery, during regular office hours, no later than the day work is commenced; or, (c) by FAX no later than the day work is commenced. If method (c) is used, the original "Watermaster Copy" of this notice shall also be mailed or delivered to the office of the district watermaster no later than the day work is commenced. The Water Resources Commission has authority to impose civil penalties for failure to submit the required \$75 fee with the start card and for failure to submit cards prior to beginning of construction, alteration, conversion or abandonment work.

RECEIVED

Owner's name and mailing address: FLOYD H. GARLAND AUG 24 2000
Home Phone: 541-573-2171 398 N. BROADWAY
Work Phone: _____ BURNS, OREGON 97720


WATER RESOURCES DEPT.
SALEM, OREGON

Check type of work: Fee Required: New Construction No Fee Required: Alteration (Repair/Recondition)
 Conversion Deepening Original Start Card Number _____
 Abandonment

Proposed Commencement Date: 8-21-00
Existing or Proposed Well Depth: 350 Diameter: 10" Original Well I.D. Label Number: _____

Check Use: Domestic Public System (Community) Industrial Irrigation Monitoring
Subdivision
 Thermal Injection Other _____

Proposed Well Location: County Harney Township: 23 S. Range: 30 E. Section: 14
North or South East or West

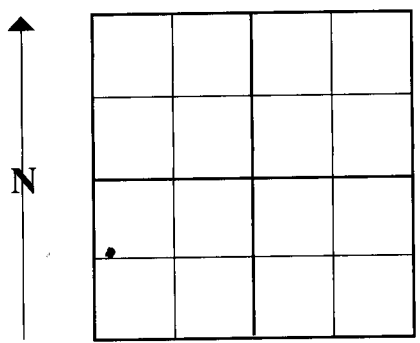

- N.W. 1/4 of S.W. 1/4 of above section.
- Street Address of well location (or directions if not assigned):
King Avenue, Garland Acres
- Tax-lot number of well location: 800
- Attach map with location identified. (See reverse for approved maps)
- Show well location within 1/4, 1/4 of section grid at left.

We hereby certify that we have read the back of this form and that the information provided is accurate to the best of our knowledge.

Floyd H. Garland Owner/Agent Travis K. Poley Bonded Water/Monitor Well Constructor License No. 1424
Aug. 21, 2000 Date Signed Western Drilling Co Company 8-21-00 Date Signed

OWNER PLEASE NOTE: This is not a water right application. The owner is responsible for obtaining a water right through the Water Resources Department, if required. The Oregon Health Division requires plans to be submitted and approved prior to construction if the well is to be used as a public system.

ADDITIONAL IMPORTANT INFORMATION ON BACK.

THIS COPY, WITH ACCOMPANYING FEE, TO WATER RESOURCES DEPARTMENT IN SALEM.