

STATE OF OREGON
WATER SUPPLY WELL REPORT

(as required by ORS 537.765)

WELL I.D. # L 90673START CARD # 193448

Instructions for completing this report are on the last page of this form.

(1) LAND OWNER David + Paula Lynn Well Number _____
 Name David + Paula Lynn
 Address 68296 Quincy Rd.
 City Burns State OR Zip 97720

(2) TYPE OF WORK ☒ New Well
☐ Deepening ☐ Alteration (repair/recondition) ☐ Abandonment ☐ Conversion

(3) DRILL METHOD
☐ Rotary Air ☐ Rotary Mud ☒ Cable ☐ Auger ☐ Cable Mud
☐ Other _____

(4) PROPOSED USE
☒ Domestic ☐ Community ☐ Industrial ☐ Irrigation
☐ Thermal ☐ Injection ☐ Livestock ☐ Other _____

(5) BORE HOLE CONSTRUCTION Special Construction: ☐ Yes ☒ No
 Depth of Completed Well 90 ft.
 Explosives used: ☐ Yes ☒ No Type _____ Amount _____

BORE HOLE			SEAL			Sacks or Pounds
Diameter	From	To	Material	From	To	
10"	0	26	Bentonite	0	26	18
6"	26	90				

How was seal placed: Method ☐ A ☐ B ☐ C ☐ D ☐ E
☒ Other poured & tamped

Backfill placed from _____ ft. to _____ ft. Material _____
 Gravel placed from _____ ft. to _____ ft. Size of gravel _____

(6) CASING/LINER

Diameter	From	To	Gauge	Steel	Plastic	Welded	Threaded
Casing: 6 1/4" x 18"	0	25	250	☒	☐	☐	☐
Liner: 4 1/2"	60	90	SDR 26	☐	☒	☒	☐

Drive Shoe used ☐ Inside ☐ Outside ☒ None

Final location of shoe(s) _____

(7) PERFORATIONS/SCREENS
☒ Perforations Method SKILL SAW
☐ Screens Type _____ Material _____

From	To	Slot Size	Number	Diameter	Tele/pipe size	Casing	Liner
70'	90'	1/8" x 1/8"	75 slots			☐	☒

(8) WELL TESTS: Minimum testing time is 1 hour
☒ Pump ☐ Bailor ☐ Air ☐ Flowing Artesian

Yield gal/min	Drawdown	Drill stem at	Time
8 gpm	15-23 ft	12 ins.	15 min pump

Temperature of water 56° Depth Artesian Flow Found _____

Was a water analysis done? ☐ Yes By whom _____

Did any strata contain water not suitable for intended use? ☐ Too little

☐ Salty ☐ Muddy ☐ Odor ☐ Colored ☐ Other _____

Depth of strata: _____

(9) LOCATION OF WELL (legal description)

County Harney
 Tax Lot 300 Lot _____
 Township 24 South N or S Range 33 E or W WM
 Section 4 NE 1/4 NW 1/4

Lat _____° _____' _____" or _____ (degrees or decimal)
 Long _____° _____' _____" or _____ (degrees or decimal)

Street Address of Well (or nearest address) 68296 Quincy Rd
Burns OR 97720

(10) STATIC WATER LEVEL

15 ft. below land surface. Date 11-28-09

_____ ft. below land surface. Date _____

Artesian pressure _____ lb. per square inch Date _____

(11) WATER BEARING ZONES

Depth at which water was first found 20 ft

From	To	Estimated Flow Rate	SWL
20'	90'	40 + gpm	15'

(12) WELL LOG

Ground Elevation 4150'

Material	From	To	SWL
Top soil	0	2	
Brown sand & clay	2	21	
grey clay w/ Brown sand	21	35	15'
green clay w/ streaks fine gravel and sand	35	90	

RECEIVED

DEC 24 2009

WATER RESOURCES DEPT
SALEM, OREGON

Date Started 6-20-09 Completed 11-28-09

(unbonded) Water Well Constructor Certification

I certify that the work I performed on the construction, deepening, alteration, or abandonment of this well is in compliance with Oregon water supply well construction standards. Materials used and information reported above are true to the best of my knowledge and belief.

WWC Number _____ Date _____

Signed _____


(bonded) Water Well Constructor Certification

I accept responsibility for the construction, deepening, alteration, or abandonment work performed on this well during the construction dates reported above. All work performed during this time is in compliance with Oregon water supply well construction standards. This report is true to the best of my knowledge and belief. Evergreen Well Drilling

WWC Number 1459 Date 12-23-09

Signed Ron J. Vetterling

EXEMPT USE WELL LOCATION MAP

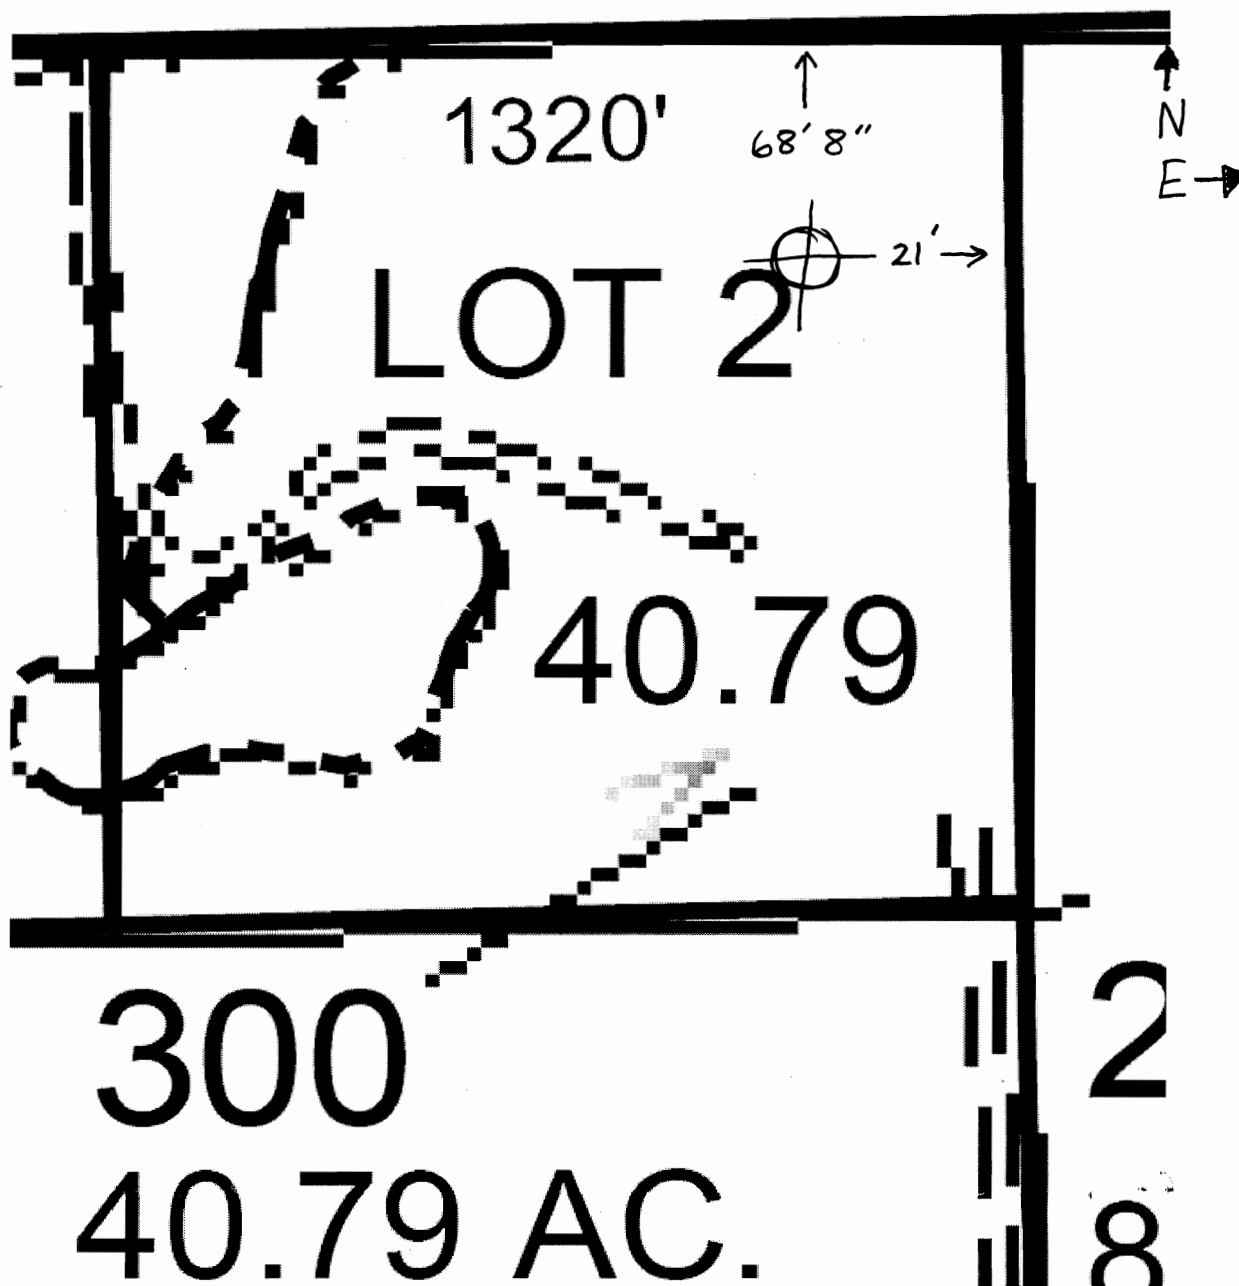

↑N

Harney County

Assessor Map Reference Number: 24S 33E 4 NENW; Tax Lot 300

Street Address of Well, if Available: 68296 Quincy Road, Burns, OR.

Well Log # HARN 51683, Well Label (ID Tag) # L 90673.

(Please Locate Well and Indicate distance From Property or Survey Corner, See Attached Sample Well Location Map.) MAP NOT TO SCALE

RECEIVED

FEB 19 2010

WATER RESOURCES DEPT
SALEM, OREGON

LAND OWNER SUBMITTED MAP