


EXEMPT USE WELL LOCATION MAP

(Please include tax lot map)

RECEIVED

JAN 28 2010

WATER RESOURCES DEPT
SALEM, OREGON

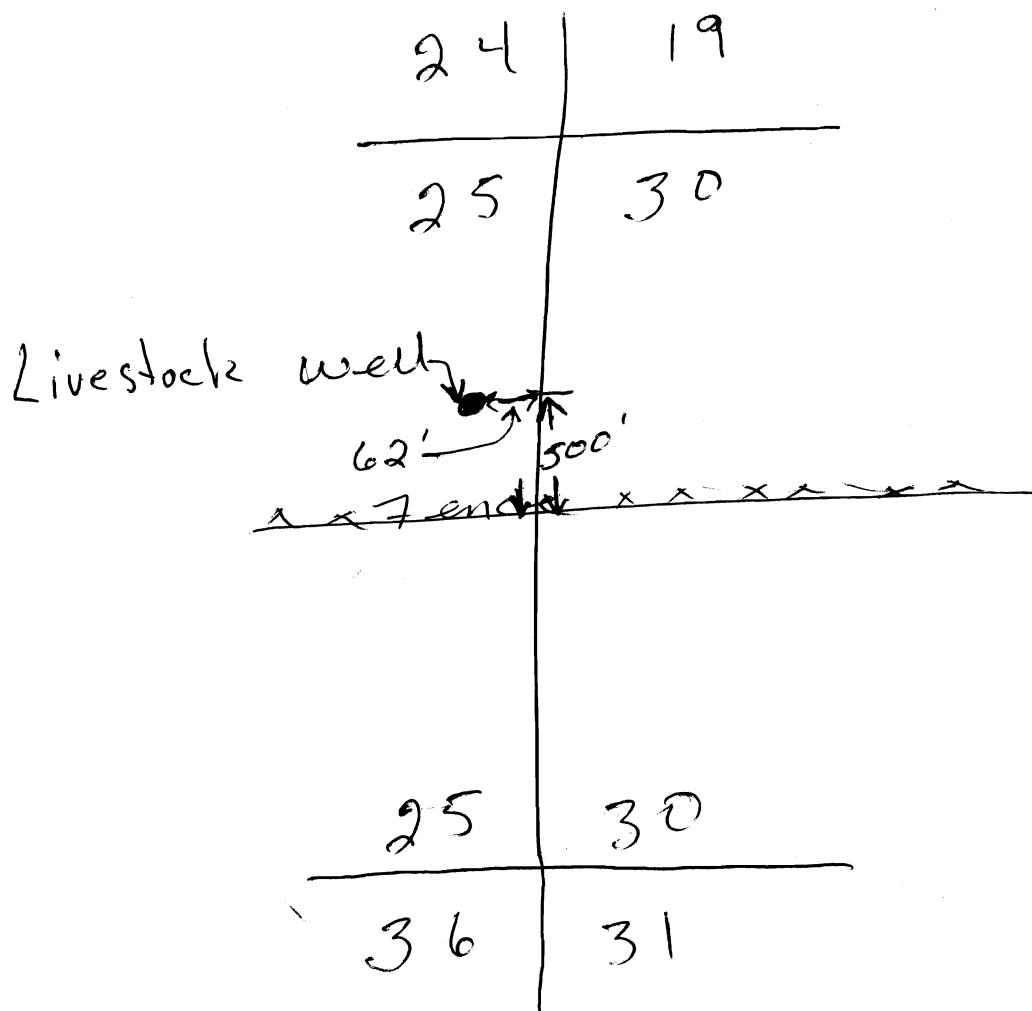

Please complete the Mapping Information
Below

↑N

Harney County

Assessor Map Reference Number: _____

Street Address of Well, if Available: none

Well Log # HARN 51684, Well Label (ID Tag) # L 19709.

(Please Locate Well and Indicate distance From Property or Survey Corner, See Attached Sample Well Location Map.) MAP NOT TO SCALE

LAND OWNER SUBMITTED MAP