

STATE OF OREGON
WATER SUPPLY WELL REPORT

(ORS 537.765 & OAR 690-205-0210)

Instructions for completing this report are on the last page of this form.

HARN 51739

WELL LABEL # L

START CARD #

ORIGINAL LOG #

104952
206687

(1) LANDOWNER Owner Well I.D. _____
First Name Cameron Last Name Koehn
Company _____
Address 37522 Sandhill Lane
City Burns State OR Zip 97720

(2) TYPE OF WORK ☒ New ☐ Conversion ☐ Deepening
☐ Alteration (complete Sections 2a & 10) ☐ Abandonment (complete Section 5a)

(2a) PRE-ALTERATION: Well Depth 360 ft.
Seal Material Bentonite
Casing Type: ☒ Steel ☐ Plastic ☐ Other _____
Casing Gauge .250 Casing Diameter 6"

(3) DRILL METHOD ☐ Rotary Air ☐ Rotary Mud ☐ Auger
☒ Cable ☐ Cable Mud ☐ Reverse Rotary ☐ Other _____

(4) PROPOSED USE ☒ Domestic ☐ Irrigation ☐ Community
☐ Industrial/Commercial ☐ Livestock ☐ Dewatering ☐ Injection
☐ Thermal ☐ Other _____

(5) BORE HOLE CONSTRUCTION
Depth of Completed Well 360 ft. Special Standard: ☐ Yes (attach copy)

BORE HOLE				SEAL				
Dia	From	To	Material	From	To	Amount	Scks/lbs	
10"	0	19	Bentonite	0	19	15	Scks	
6"	19	360						

How was seal placed: Method ☐ A ☐ B ☐ C ☐ D ☐ E
☐ Other Poured

Backfill placed from _____ ft. to _____ ft. Material _____
Filter pack from _____ ft. to _____ ft. Material _____ Size _____

(5a) ABANDONMENT USING UNHYDRATED BENTONITE:
Calculated Amount Proposed to be Used: _____ sacks/lbs
Actual Amount Used: _____ sacks/lbs

(6) CASING/LINER

Csing/Linr	Dia	+	From	To	Gauge	Steel	Plastic	Welded	Thrd
X	6"	X	1	140'	.250	X		X	
X	4 1/2"		136	360	5/16"		X		

Shoe ☐ Inside ☒ Outside ☐ Other Location of shoe(s) _____
Temporary casing ☐ Yes Diameter _____ From _____ To _____

(7) PERFORATIONS/SCREENS
Perforations Method _____
Screens Type _____ Material _____

Perf	Scrn	Csing	Linr	Screen Dia	From	To	Screen/slot width	Slot length	# of slots	Tele/pipe size

(8) WELL TESTS: Minimum testing time is 1 hour
☒ Pump ☐ Bailer ☐ Air ☐ Flowing Artesian

Yield gal/min 20 Drawdown 15' Drill stem/Pump depth 120' Duration (hr) 2 hrs

Temperature 55 °F Lab analysis ☐ Yes By _____

Water quality concerns? ☐ Yes (describe below) TDS _____ ppm

From	To	Description	Amount	Units

(9) LOCATION OF WELL (legal description)
County Harney Twp 24 N or S Range 32 1/2 E or W W.M.
Sec 16 NW 1/4 of the SW 1/4 Tax Lot 4400
Tax Map Number _____ Lot _____
Lat _____ " or _____ DMS or DD
Long _____ " or _____ DMS or DD

Street Address of Well (or nearest address) 37522 Sandhill Lane Burns OR 97720

(10) STATIC WATER LEVEL

	Date	SWL (psi)	+	SWL (ft)
Existing Well/Pre-Alteration				
Completed Well	<u>10-28-10</u>			<u>60'</u>

Flowing Artesian? ☐ Yes Dry Hole? ☐ Yes
WATER BEARING ZONES Depth water was first found 42'

SWL Date	From	To	Est Flow	SWL (psi)	+	SWL (ft)
<u>9-3-10</u>	<u>42'</u>	<u>43'</u>	<u>26 p.m.</u>			<u>42'</u>
	<u>353'</u>	<u>360'</u>	<u>20</u>			<u>60'</u>

(11) WELL LOG Ground Elevation 4100

Material	From	To
TOP SOIL	1'	2'
Sandy clay	2'	42'
Sandstone	42'	65'
Black sand	65'	97'
Clay	97'	345'
Pumice	345'	353'
Sand/Gravel	353'	360'

Date Started 9-1-10 Completed 10-28-10

(unbonded) Water Well Constructor Certification
I certify that the work I performed on the construction, deepening, alteration, or abandonment of this well is in compliance with Oregon water supply well construction standards. Materials used and information reported above are true to the best of my knowledge and belief.

License Number _____ Date _____

Signed _____

(bonded) Water Well Constructor Certification
I accept responsibility for the construction, deepening, alteration, or abandonment work performed on this well during the construction dates reported above. All work performed during this time is in compliance with Oregon water supply well construction standards. This report is true to the best of my knowledge and belief.

License Number 1752 Date 11-24-10

Signed Kenneth E Smith
Contact Info. (optional) _____

RECEIVED

FEB 24 2011

STATE OF OREGON
WATER SUPPLY WELL REPORT

(ORS 537.765 & OAR 690-205-0210)

Instructions for completing this report are on the last page of this form.

HARN 51739

WELL LABEL # L 104952
START CARD # 206681
ORIGINAL LOG #

(1) LANDOWNER Owner Well I.D.
First Name Cameron Last Name Koehn
Company _____
Address 37522 Sandhill Lane
City Burns State OR Zip 97720

(2) TYPE OF WORK ☒ New ☐ Conversion ☐ Deepening
☐ Alteration (complete Sections 2a & 10) ☐ Abandonment (complete Section 5a)

(2a) PRE-ALTERATION: Well Depth 360 ft.
Seal Material Bentonite
Casing Type: ☒ Steel ☐ Plastic ☐ Other
Casing Gauge 250 Casing Diameter 6"

(3) DRILL METHOD ☐ Rotary Air ☐ Rotary Mud ☐ Auger
☒ Cable ☐ Cable Mud ☐ Reverse Rotary ☐ Other

(4) PROPOSED USE ☒ Domestic ☐ Irrigation ☐ Community
☐ Industrial/Commercial ☐ Livestock ☐ Dewatering ☐ Injection
☐ Thermal ☐ Other

(5) BORE HOLE CONSTRUCTION
Depth of Completed Well 360 ft. Special Standard: ☐ Yes (attach copy)

BORE HOLE			SEAL			Amount	Scks/lbs
Dia	From	To	Material	From	To		
10"	0	19	Bentonite	0	19	15	Sch

How was seal placed: Method ☐ A ☐ B ☐ C ☐ D ☐ E

☐ Other Poured
Backfill placed from _____ ft. to _____ ft. Material _____
Filter pack from _____ ft. to _____ ft. Material _____ Size _____

(5a) ABANDONMENT USING UNHYDRATED BENTONITE:

Calculated Amount Proposed to be Used: _____ sacks/lbs
Actual Amount Used: _____ sacks/lbs

(6) CASING/LINER

Csng	Linr	Dia	+	From	To	Gauge	Steel	Plastic	Welded	Thrd
X		6"	±	1	140'	250	X			X
	X	4 1/2"		136	360	51480		X		

Shoe ☐ Inside ☒ Outside ☐ Other Location of shoe(s) _____
Temporary casing ☐ Yes Diameter _____ From _____ To _____

(7) PERFORATIONS/SCREENS

Perforations Method _____
Screens Type _____ Material _____

Perf	Scrn	Csng	Linr	Screen Dia	From	To	Screen/ slot width	Slot length	# of slots	Tele/ pipe size

(8) WELL TESTS: Minimum testing time is 1 hour

☒ Pump ☐ Bailor ☐ Air ☐ Flowing Artesian
Yield gal/min 20 Drawdown 15' Drill stem/Pump depth 120' Duration (hr) 2 hrs
Temperature 55 °F Lab analysis ☐ Yes By _____
Water quality concerns? ☐ Yes (describe below) TDS _____ ppm
From _____ To _____ Description _____ Amount _____ Units _____

(9) LOCATION OF WELL (legal description)

County harney Twp 27 N or S Range 32 1/2 E or W W.M.
Sec 16 NW 1/4 of the SW 1/4 Tax Lot 4400
Tax Map Number _____ Lot _____
Lat _____ " or _____ DMS or DD
Long _____ " or _____ DMS or DD

Street Address of Well (or nearest address) 37522 Sandhill Ln
Burns OR 97720

(10) STATIC WATER LEVEL

	Date	SWL (psi)	+	SWL (ft)
Existing Well/Pre-Alteration				
Completed Well	<u>10-28-10</u>			<u>60'</u>

Flowing Artesian? ☐ Yes Dry Hole? ☐ Yes

WATER BEARING ZONES Depth water was first found 42'

SWL Date	From	To	Est Flow	SWL (psi)	+	SWL (ft)
<u>9-3-10</u>	<u>42'</u>	<u>43'</u>	<u>26 p.m</u>			<u>42'</u>
	<u>393'</u>	<u>360'</u>	<u>20</u>			<u>60'</u>

(11) WELL LOG

Ground Elevation 4100

Material	From	To
TOP SOIL	1'	2'
Sandy Clay	2'	42'
Sandstone	42'	65'
Black sand	65'	97'
Clay	97'	345'
Pumice	345'	353'
Sand / gravel	353'	360'

Date Started 9-1-10 Completed 10-28-10

(unbonded) Water Well Constructor Certification

I certify that the work I performed on the construction, deepening, alteration, or abandonment of this well is in compliance with Oregon water supply well construction standards. Materials used and information reported above are true to the best of my knowledge and belief.

License Number _____ Date _____

Signed _____

(bonded) Water Well Constructor Certification


I accept responsibility for the construction, deepening, alteration, or abandonment work performed on this well during the construction dates reported above. All work performed during this time is in compliance with Oregon water supply well construction standards. This report is true to the best of my knowledge and belief.

License Number 1752 Date 11-24-10

Signed Kenneth E Smith
Contact Info. (optional)

HARN 51739
HARN 51739

HARN 51739

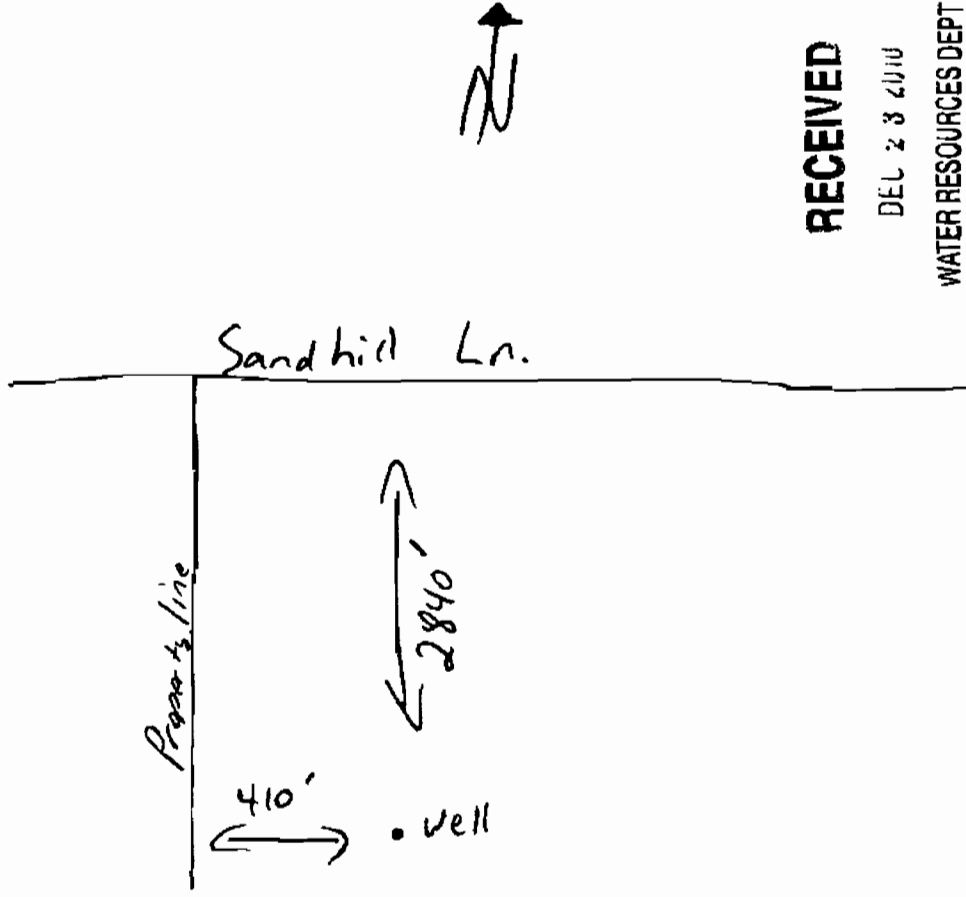

RECEIVED

DEC 23 2010

WATER RESOURCES DEPT
SALEM, OREGON

LAND OWNER SUBMITTED MAP