

STATE OF OREGON

# WATER SUPPLY WELL REPORT

(as required by ORS 537.765 & OAR 690-205-0210)

**09-05-2011**

WELL LABEL# L 94008

START CARD # 1011966

[illegible]

ORIGINAL - WATER RESOURCES DEPARTMENT

THIS REPORT MUST BE SUBMITTED TO THE WATER RESOURCES DEPARTMENT WITHIN 30 DAYS OF COMPLETION OF WORK

Form Version: 0.95

# HARN 51805

**WATER SUPPLY WELL REPORT -  
continuation page**

HARN 51805

WELL I.D. # L 94008

Page 2 of 2

**09-05-2011**

START CARD # 1011966

### (5) BORE HOLE CONSTRUCTION

[illegible]

FILTER PACK

| From | To | Material | Size |
|------|----|----------|------|
|      |    |          |      |
|      |    |          |      |
|      |    |          |      |

### (6) CASING/LINER

| Casing Liner | Dia | + | From | To | Gauge | Stl | Plstc | Wld | Thrd |
|--------------|-----|---|------|----|-------|-----|-------|-----|------|
|              |     |   |      |    |       |     |       |     |      |
|              |     |   |      |    |       |     |       |     |      |
## (7) PERFORATIONS/SCREENS

[illegible]

**(8) WELL TESTS:** Minimum testing time is 1 hour

| Yield gal/min | Drawdown | Drill stem/Pump depth | Duration (hr) |
|---------------|----------|-----------------------|---------------|
|               |          |                       |               |
|               |          |                       |               |
### Water Quality Concerns

| From | To | Description | Amount | Units |
|------|----|-------------|--------|-------|
|      |    |             |        |       |
|      |    |             |        |       |
### (10) STATIC WATER LEVEL

### Water Bearing Zones


[illegible]

**(11) WELL LOG**

[illegible]

### Comments/Remarks

The start card stated NE 1/4 of SE 1/4. I changed the log to read SE 1/4 of SE 1/4, which is the correct description.

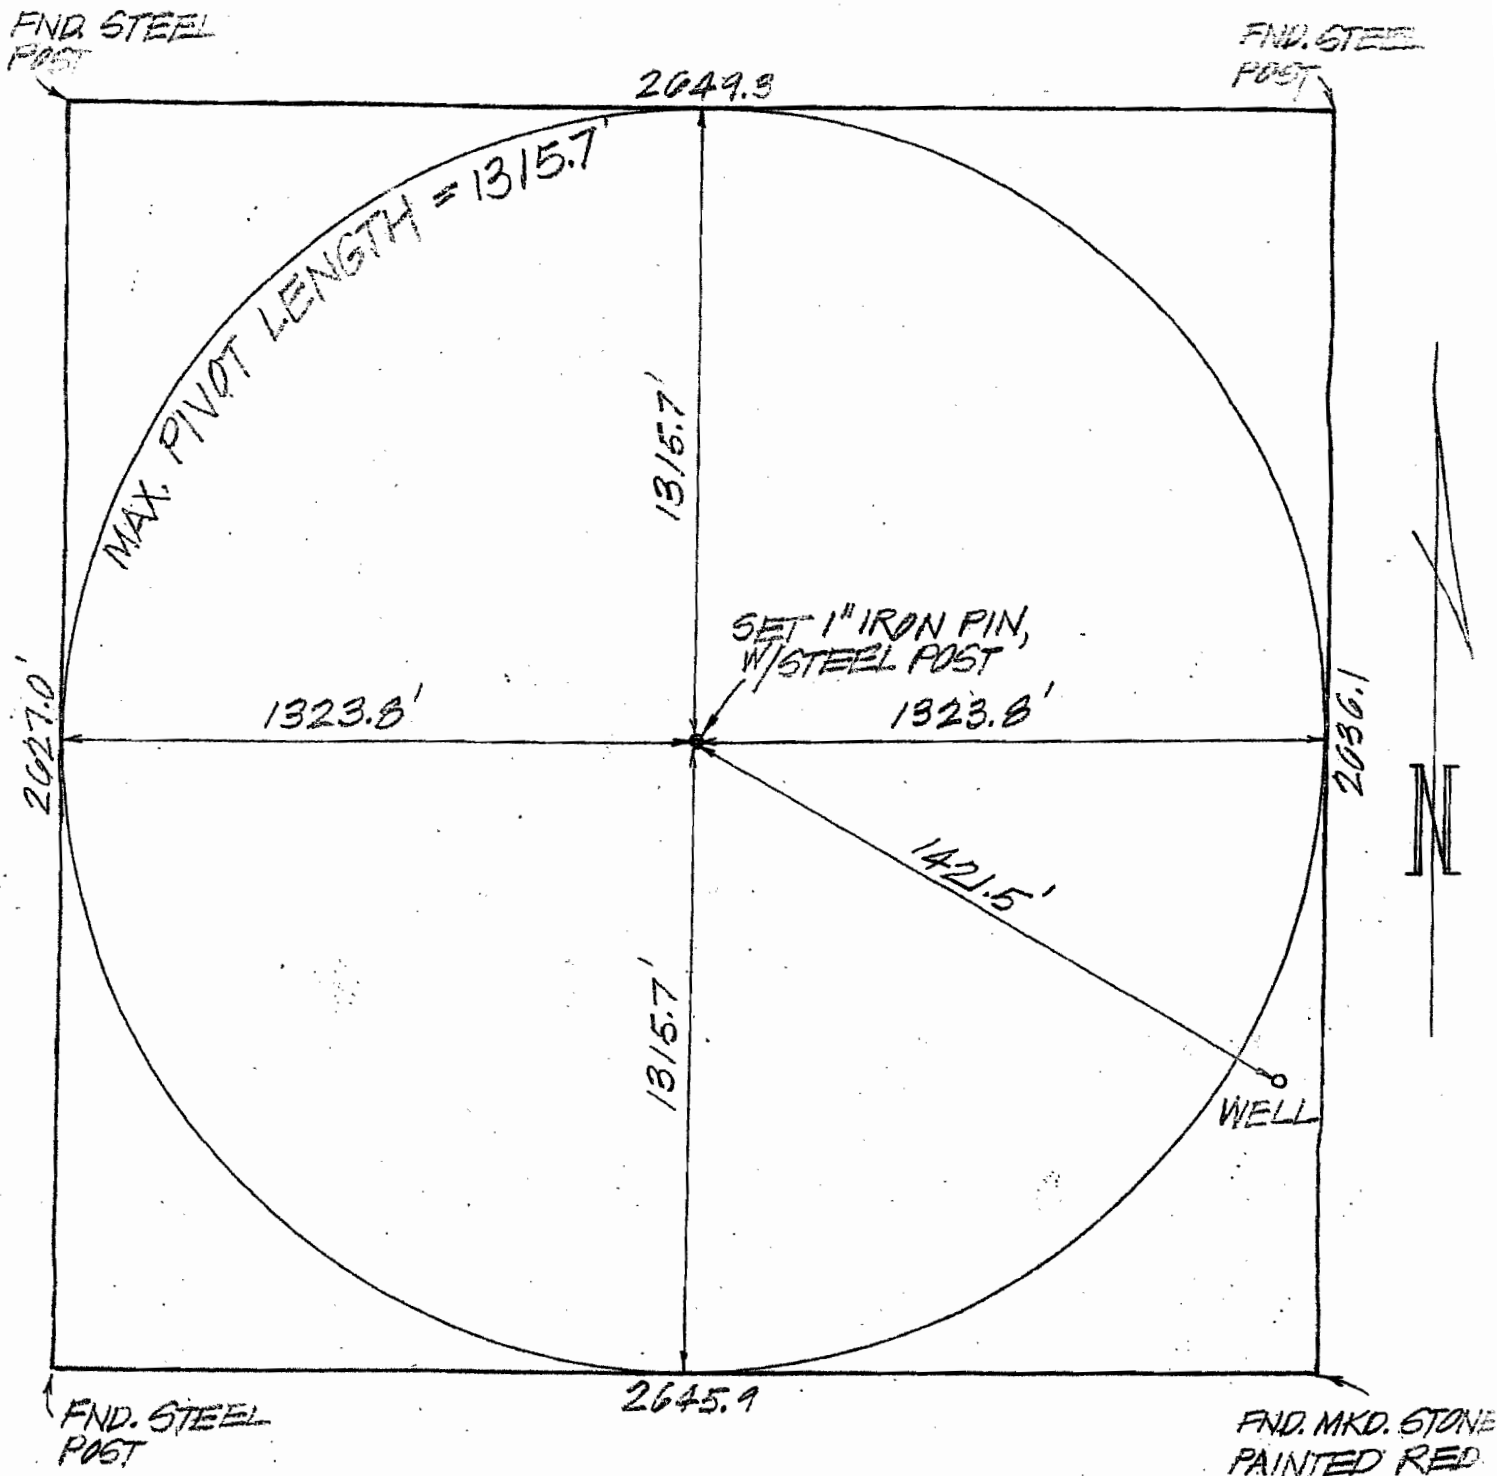

1 mile West of Hwy 78

JAMES WILSON

IRRIGATION SURVEY

SE 1/4 SECTION 23, T26S, R33E, WM

Scale: 1" = 400'

Date: SEPT. 2011

Job: 2273

Dsn:

h

M.A. PALMER & SONS INC

Sht No

REGISTERED  
PROFESSIONAL  
LAND SURVEYOR

OREGON  
SEPTEMBER 23, 1977  
CHRIS T. PALMER

LAND OWNER SUBMITTED MAP

RECEIVED