
				// *	Page 1 of 2
STATE OF OREGON	HARN	51887	WELL I.D. LABEL		
WATER SUPPLY WELL REPORT	1010 -		START CARD	1010070	
(as required by ORS 537.765 & OAR 690-205-0210)	10/25	/2012	ORIGINAL LOG	#	
(1) LAND OWNER Owner Well I.D.					
First Name STEVE & KRISTI Last Name RICKMAN		(9) LOCATI	ON OF WELL (lega	l description)	
Company		County HARNEY	Twp 23.00 S	N/S Range 31.	.00 E E/W WM
Address 69705 OLD EXPERIMENT ROAD City BURNS State OR Zip 97720		Sec 24 S	E 1/4 of the NE	1/4 Tax Lot	201
••••		Tax Map Numbe	r" or	Lot	
(2) TYPE OF WORK New Well Deepening Conv. Alteration (complete 2a & 10) Abandonment(co	ersion	Lat°	' or		DMS or DD
(2a) PRE-ALTERATION	mplete 5a)	Long°	" or		DMS or DD
Dia + From To Gauge Stl Plstc Wld Thrd		\sim	\mathcal{Q}	Nearest address	
Casing:		69705 OLD EX	PERIMENT ROAD BUR	NS,OR 97720	
Material From To Amt sacks/lbs					
(3) DRILL METHOD		(10) STATIC	WATER LEVEL		
Rotary Air 🗙 Rotary Mud Cable Auger Cable Mud		. ,	D	ate SWL(psi)	+ SWL(ft)
Reverse Rotary Other			ll / Pre-Alteration		
		Completed V	Well 9/30/20 Flowing Artesian?		51
Industrial/Commercial Livestock Dewatering			-	water was first for	
ThermalOther		SWL Date	From To	Est Flow SWL(ps	si) + SWL(ft)
(5) BORE HOLE CONSTRUCTION Special Standard (4	Attach copy)	5/10/2012	9 24	20	9
Depth of Completed Well <u>307.00</u> ft.		5/10/2012	50 68	30	25
BORE HOLE SEAL Dia From To Material From To A	sacks/	5/11/2012	94 303	200	51
	mt lbs 20 S				
	70 S				
18 276 310		(11) WELL L	06		
			Glouid Eleva	-	
	E		Material	From	To
Source Anticipation Anticipation Sector Sect		top soil clay black		0	2 9
Filter pack from 0 ft. to 85 ft. Material PEA GRAVSize p		sand & gravel		9	24
	bea gravel	clay dark grey		24	50
Explosives used: Yes Type Amount		sand & gravel		50	60
(5a) ABANDONMENT USING UNHYDRATED BENTONI	ГЕ	clay grey		60	66
Proposed Amount Actual Amount		sand & gravel clay grey		66 68	<u>68</u> 94
(6) CASING/LINER		clay grey w/crac	ks black sand	94	288
$\begin{array}{ c c c c c c c c c c c c c c c c c c c$		fractured gravel		288	303
		clay grey		303	400
$\begin{array}{c c c c c c c c c c c c c c c c c c c $	XX				
$\bigcirc \bigcirc \bigcirc 12 \ \Box 227 \ 287 \ \text{SDR-11} \ \bigcirc \bigcirc \bigcirc$					
Shoe Inside Outside Other Location of shoe(s)					
Temp casing Yes Dia From To					
(7) PERFORATIONS/SCREENS					
Perforations Method					
Screens Type <u>slotted/V-wire</u> Material <u>PVC/St.St.</u> Perf/ Casing/Screen <u>Scrn/slot</u> Slot # of	Tele/	Date Started 5	<u>/8/2012</u> Co	omplete <u>9/30/20</u>	012
6	pipe size	(unbonded) Wa	ter Well Constructor Cer	tification	
Screen Liner 12 127 227 .032	12	2	e work I performed on the	· · · · ·	1 0,
Screen Liner 12 287 307 .06	12	abandonment o	f this well is in complia	nce with Oregon	water supply well
			ndards. Materials used and nowledge and belief.	information repoi	rted above are true to
			-	Date	
(8) WELL TESTS: Minimum testing time is 1 hour					
	ntagion	Signed			
Pump Bailer Air Flowing A		(honded) Water	Well Constructor Certifi	action	
Yield gal/minDrawdownDrill stem/Pump depthDuration (h2102242758	1r)	, ,			tion or chandonmon
			ibility for the construction on this well during the cons		
		performed durin	g this time is in complia	ance with Oregor	n water supply well
Temperature 57 °F Lab analysis Yes By		construction stan	dards. This report is true to	the best of my kn	owledge and belief.
Water quality concerns? Yes (describe below) TDS amount		License Number	1899	Date 10/15/2012	
From To Description Amount	Units				
	├┤ │				
		Contact Into (op	tional)		

ORIGINAL - WATER RESOURCES DEPARTMENT THIS REPORT MUST BE SUBMITTED TO THE WATER RESOURCES DEPARTMENT WITHIN 30 DAYS OF COMPLETION OF WORK Form Version:

WATER SUPPLY WELL REPORT -

continuation page

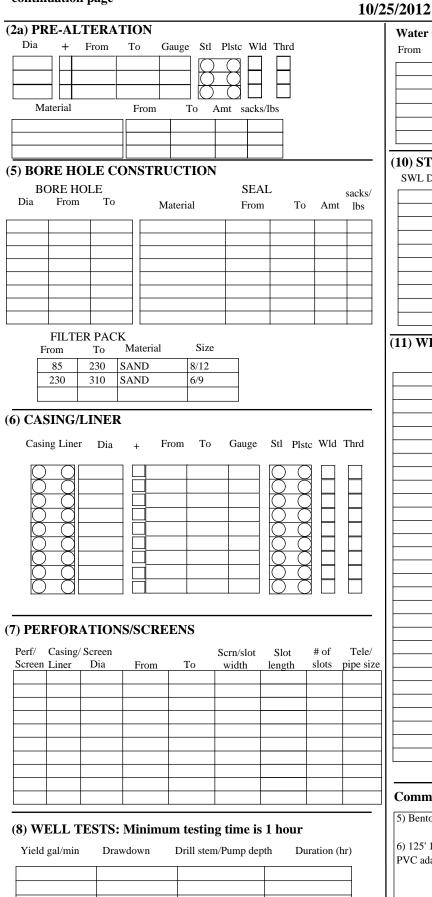

WELL I.D. LABEL# L 96843 START CARD # 1016576 ORIGINAL LOG

Water Quality Concerns

HARN 51887

~~~~~~~~~~~~~~~~~~~~~~~~~~~~~~~~~~~~~~	aang 00			
From	То	Description	Amount	Units

## (10) STATIC WATER LEVEL

SWL Date	From	То	Est Flow	SWL(psi)	+	SWL(ft)
					-	

# (11) WELL LOG

Material	From	То

#### **Comments/Remarks**

5) Bentonite chips poured from surface, cement method "C" tremie pipe

6) 125' 127' is a 12 X 14 steel reducer welded to the 14" casing and a steel X PVC adapter,