

**HARN 52247**

**RECEIVED**  
APR 6 1961  
**STATE ENGINEER**  
SALEM OREGON

Log on Lester Tyler well

12" hole 200' deep

20 ft. down to 74 ft. gravel and clay  
74 ft. down to 79 ft. yellow clay  
79 ft. down to 110 ft. red cinders and clay  
110 ft. down to 117 ft. hard red rock  
117 ft. down to 165 ft. hard black cinders  
165 ft. down to 200ft. cinders pumice and gravel

Driller Paul G. Chrisley

Sign

Paul Chrisley

Form B

Application No. G-1977

## NOTICE OF COMPLETION OF CONSTRUCTION

I, Lester Tyler, the holder of Permit No. G-1813  
 to appropriate the public waters of the state of Oregon, completed the construction of the works described  
 therein on the 7th day of April, 1961.

Remarks:

If the works have less capacity than described in the permit, or you have definitely abandoned part of the proposed development, you

should so state in order that our records may not be unnecessarily encumbered.

Lester Tyler

IN WITNESS WHEREOF, I have hereunto set my hand this 9 day of June, 1961.

(Signature of Applicant)

Burns Oregon Box 693

(Address)

Fill out, detach, and mail to the State Engineer, Salem, Oregon, when construction work is completed.

Form C

**IMPORTANT**—This form is a notice to the State Engineer that permittee is ready to make final proof to the extent to which the water has actually been applied to the intended use under the terms of the permit. Permittee is cautioned that Certificate of Water Right will be issued based on the extent of the quantity and use as determined by the final proof inspection and survey which will be made in response to the filing of this Form C.

NOTE: In the case of an irrigation permit, this Form C should not be mailed to the State Engineer until all of the land described in the permit, which it is intended to irrigate under this permit at any time, has actually been irrigated.

Fill out, detach and mail to the State Engineer, Salem, Oregon, when all of the water has been applied.

Application No. G-1977

## NOTICE OF COMPLETE APPLICATION OF WATER TO A BENEFICIAL USE

I, Lester Tyler, the holder of Permit No. G-1813  
 to appropriate the public waters of the state of Oregon, completely applied the waters to a beneficial use in  
 accordance with the terms of said permit, on the 7th day of April, 1961.

Remarks:

IN WITNESS WHEREOF, I have hereunto set my hand this 9 day of June, 1961.

Lester Tyler


(Signature of Applicant)

Burns Oregon Box 693

(Address)

Lester Tyler

T.23 S.R.31E.W. M.

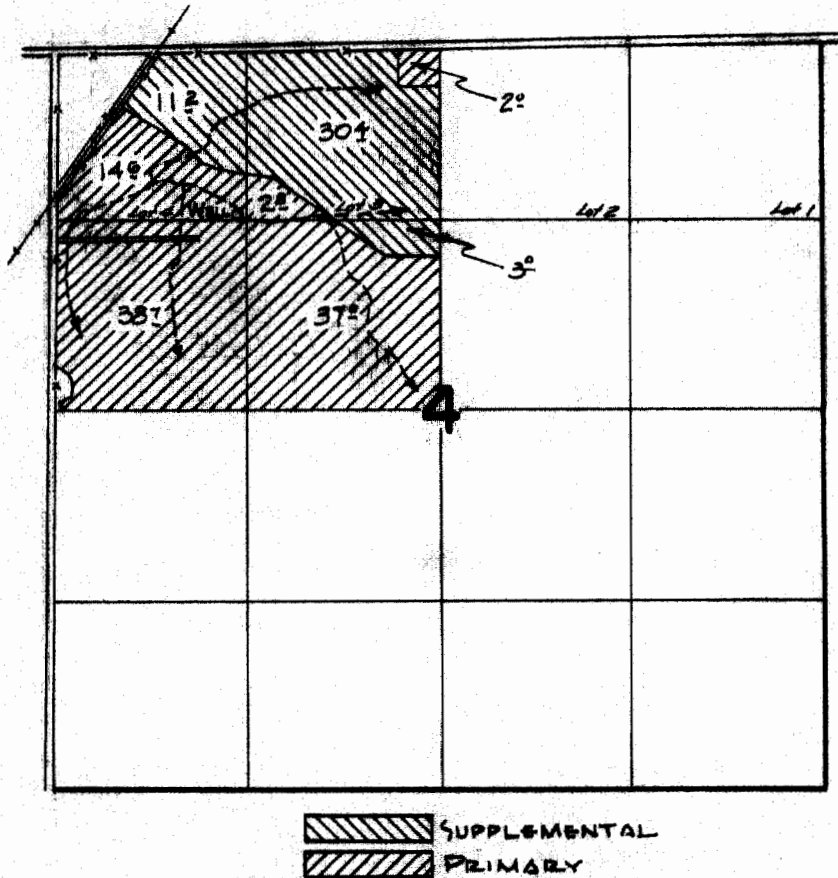

**FINAL PROOF SURVEY**  
UNDER

Application No. G-1977 Permit No. G-1813.  
IN NAME OF

LESTER TYLER

Surveyed Sept. 14 1963, by C. R. BAKER

## Abstract of Permit No. G-1813 ✓

Application No. G-1977 ✓

Certificate No.

Name

Lester Tyler ✓

Address

Burns, Oregon ✓

Source of water supply

Tyler Well #2, trib. of Foley Sl., trib. of (Silvies River),  
~~trib. of Malheur Lake,~~  
supplemental irrigation of 44.6 ac.

Use

Point of diversion

Lot 4 1110' S. & 1400' W. from the N. cor. of Sec. 4, being within  
the (NW 1/4 NW 1/4) Sec. 4, T. 23 S., R. 31 E., W.M., in the county  
of Harney

Number of acres

145.6

Well is located 17 1/2 chs. South and 19 chs. East from  
NW corner Section 4 ✓  
DESCRIPTION OF LAND TO BE IRRIGATED OR PLACE OF USE

| Twp. | Range | Sec. | NE 1/4 |        |        |        | NW 1/4 |        |        |        | SW 1/4 |        |        |        | SE 1/4 |        |        |        |
|------|-------|------|--------|--------|--------|--------|--------|--------|--------|--------|--------|--------|--------|--------|--------|--------|--------|--------|
|      |       |      | NE 1/4 | NW 1/4 | SW 1/4 | SE 1/4 | NE 1/4 | NW 1/4 | SW 1/4 | SE 1/4 | NE 1/4 | NW 1/4 | SW 1/4 | SE 1/4 | NE 1/4 | NW 1/4 | SW 1/4 | SE 1/4 |

|                 |                            | Primary                  | Supp. | Total  |       |
|-----------------|----------------------------|--------------------------|-------|--------|-------|
| T2 <sup>3</sup> | S. R. 31 E. W.M. Section 4 | NE 1/4 NW 1/4 ✓          | 4.8   | 30.4 ✓ | 35.2  |
|                 |                            | NW 1/4 NW 1/4 ✓          | 14.6  | 11.2 ✓ | 25.8  |
|                 |                            | <del>SW 1/4 NW 1/4</del> | 38.7  |        | 38.7  |
|                 |                            | SE 1/4 NW 1/4 ✓          | 37.0  | 3.0 ✓  | 40.0  |
|                 |                            |                          | 95.1  | 44.6   | 139.7 |

Priority date

April 6, 1961 ✓

Amount of water

C. 56  
1.82 c.f.s., ~~measured at the point of diversion~~

Time limit to begin construction

May 17, 1962

Time limit to complete construction 10/1/62 extended to

extended to

Time limit to completely apply water 10/1/63 extended to

extended to

This appropriation shall be limited to 1/80th of 1 c.f.s. or its equiv. for each acre  
 Remarks: irrigated & shall be further limited to a diversion of not to exceed 3 a.f.  
 per acre for each acre irrigated during the irrigation season of each year; the right  
 allowed hereunder for the appropriation of water for lands having a valid prior right  
 shall be limited to the amount necessary to make up any deficiency in water available to  
 said lands under said prior right & the amount allowed herein, together with the amount  
 secured under any other right existing for said lands, shall be limited by the duty of  
 water as fixed herein, and shall be subject to such reasonable rotation system as  
 ordered by the proper state officer.