

STATE ENGINEER
Salem, Oregon

OBSERVATION WELL
Well Record

STATE WELL NO. 23/32-3A(2)
COUNTY _____
APPLICATION NO. _____

OWNER: MEADOWLAND RANCHES INC.

MAILING ADDRESS: BURNS

LOCATION OF WELL: Owner's No. _____

CITY AND STATE: _____

NE 1/4 NE 1/4 Sec. 3 T. 23 ^{N.} S., R. 32 ^{E.} W., W.M.

Bearing and distance from section or subdivision corner _____


Altitude at well _____

TYPE OF WELL: DRILLED Date Constructed _____

Depth drilled 220 Depth cased _____

CASING RECORD:

12 INCH

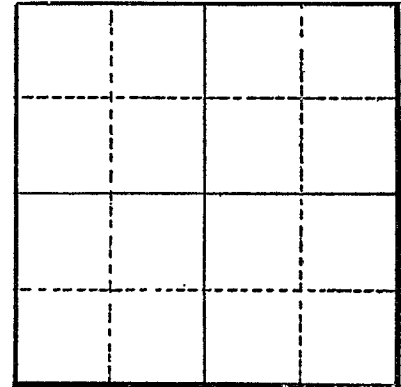

Section 3

FINISH:

AQUIFERS:

WATER LEVEL:

7.94' (11-29-65)

PUMPING EQUIPMENT: Type _____ H.P. _____
Capacity _____ G.P.M.

WELL TESTS:

Drawdown _____ ft. after _____ hours _____ G.P.M.

Drawdown _____ ft. after _____ hours _____ G.P.M.

USE OF WATER IRRIGATION Temp. _____ °F. _____, 19 _____

SOURCE OF INFORMATION _____

DRILLER or DIGGER _____

ADDITIONAL DATA:

Log NA Water Level Measurements ☒ Chemical Analysis _____ Aquifer Test _____

REMARKS: