

STATE ENGINEER
Salem, Oregon

Well Record

STATE WELL NO. 23/32-7Q(2)
COUNTY Harney
APPLICATION NO. _____

HAZV 550


OWNER: Ray (formerly Exp. Sta.)

MAILING ADDRESS: _____
CITY AND STATE: _____

LOCATION OF WELL: Owner's No. _____

SW $\frac{1}{4}$ SE $\frac{1}{4}$ Sec. 7 T. 23 ^{N.} S., R. 32 ^{E.} W., W.M.

Bearing and distance from section or subdivision corner _____

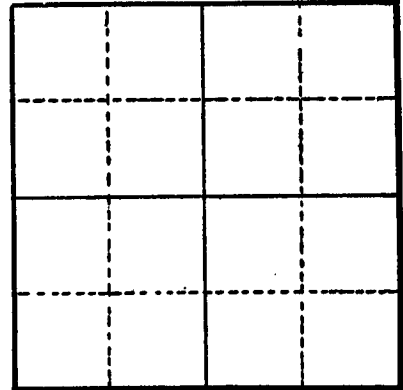

Section 7

Altitude at well _____

TYPE OF WELL: Drilled Date Constructed _____

Depth drilled 11 Depth cased _____

CASING RECORD:

4-inch

FINISH:

AQUIFERS:

WATER LEVEL:

PUMPING EQUIPMENT: Type _____ H.P. _____
Capacity _____ G.P.M.

WELL TESTS:
Drawdown _____ ft. after _____ hours _____ G.P.M.
Drawdown _____ ft. after _____ hours _____ G.P.M.

USE OF WATER None Temp. _____ °F. _____, 19_____

SOURCE OF INFORMATION Well #96 WSP 841

DRILLER or DIGGER _____

ADDITIONAL DATA:
Log _____ Water Level Measurements Chemical Analysis _____ Aquifer Test _____

REMARKS:

STATE ENGINEER
Salem, Oregon

State Well No. 33/22-70(2)

County HARNEY

Application No. _____

Water Level Record

OWNER: Ran. (Formerly Exp. Sta.) OWNER'S NO. _____

Description of measuring point: Lead Surveys

W. 11 296, 249, 251

436

Date	Water Level Feet (above) Lead Surface	Remarks	Date	Water Level Feet (above) Lead Surface	Remarks
		<u>See P. 100-28 L11</u>			
		<u>See P. 100-28 L12</u>			
		<u>1910 - 28</u>			

REMARKS: _____
