

STATE ENGINEER
Salem, Oregon

OBSERVATION WELL

Well Record

STATE WELL NO. 23/32 1/2-1D0
COUNTY HARNEY
APPLICATION NO. _____

OWNER: Ed Mc CONVILLE

MAILING ADDRESS: BURNS

LOCATION OF WELL: Owner's No. _____

CITY AND STATE: _____

NW 1/4 NW 1/4 Sec. 1 T. 23 N. R. 32 1/2 E. W.M.

Bearing and distance from section or subdivision

corner _____


Altitude at well _____

TYPE OF WELL: DRILLED Date Constructed _____

Depth drilled 300 Depth cased _____

CASING RECORD:

18 INCH

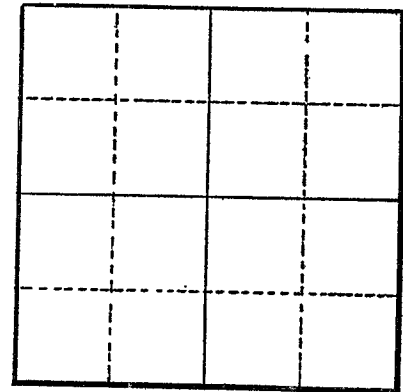

Section 1

FINISH: _____

AQUIFERS: _____

WATER LEVEL:

6.03' (5-17-65)

PUMPING EQUIPMENT: Type _____

Capacity _____ G.P.M.

H.P. _____

WELL TESTS:

Drawdown _____ ft. after _____ hours

G.P.M.

Drawdown _____ ft. after _____ hours

G.P.M.

USE OF WATER IRRIGATION

Temp. _____ °F.

19

SOURCE OF INFORMATION PERM. G-2451

DRILLER or DIGGER _____

ADDITIONAL DATA:

Log NA Water Level Measurements ☒

Chemical Analysis _____

Aquifer Test _____

REMARKS: _____