

NOTICE TO WATER WELL CONTRACTOR

The original and first copy
of this report are to be
filed with the

STATE ENGINEER, SALEM, OREGON

within 30 days from the date
of well completion.

RECEIVED
AUG 17 1970

WATER WELL REPORT

STATE OF OREGON

(Please type or print)

SALEM, ORE.

(Do not write above this line)

State Well No.

23/34-186d

State Permit No.

(1) OWNER:

Name DICK ARNOLD
Address CRANE OREGON

(2) TYPE OF WORK (check):

New Well ☒ Deepening ☐ Reconditioning ☐ Abandon ☐

If abandonment, describe material and procedure in Item 12.

(3) TYPE OF WELL:

Rotary ☐ Driven ☐
Cable ☒ Jetted ☐
Dug ☐ Bored ☐

(4) PROPOSED USE (check):

Domestic ☐ Industrial ☐ Municipal ☐
Irrigation ☒ Test Well ☐ Other ☐

(5) CASING INSTALLED:

Threaded ☐ Welded ☒
12" Diam. from 0 ft. to 20 ft. Gage 1250
" Diam. from ft. to ft. Gage
" Diam. from ft. to ft. Gage

(6) PERFORATIONS:

Perforated? ☒ Yes ☐ No.

Type of perforator used TOREH
Size of perforations 4 in. by 6 in.
896 perforations from 20 ft. to 60 ft.
perforations from ft. to ft.
perforations from ft. to ft.
perforations from ft. to ft.
perforations from ft. to ft.

(7) SCREENS:

Well screen installed? ☐ Yes ☒ No

Manufacturer's Name
Type Model No.
Diam. Slot size Set from ft. to ft.
Diam. Slot size Set from ft. to ft.

(8) WATER LEVEL: Completed well.

Static level 8' 8" ft. below land surface Date 8-11-70
Artesian pressure lbs. per square inch Date

(9) WELL TESTS:

Drawdown is amount water level is
lowered below static level

Was a pump test made? ☒ Yes ☐ No If yes, by whom? DRILLER
Yield: 500 gal./min. with 50 ft. drawdown after 29 hrs.
" " " " " " " "

Bailer test gal./min. with ft. drawdown after hrs.
Artesian flow g.p.m. Date

Temperature of water 50 Was a chemical analysis made? ☐ Yes ☒ No

(10) CONSTRUCTION:

Well seal—Material used Concrete
Depth of seal 18 ft.
Diameter of well bore to bottom of seal 24 in.
Were any loose strata cemented off? ☐ Yes ☒ No Depth
Was a drive shoe used? ☒ Yes ☐ No
Did any strata contain unusable water? ☐ Yes ☒ No
Type of water? depth of strata

Method of sealing strata off

Was well gravel packed? ☒ Yes ☐ No Size of gravel: 3" 3/4"
Gravel placed from 18 ft. to 60 ft. 8 4

(11) LOCATION OF WELL:

County HARVEY Driller's well number
SE 1/4 NW 1/4 Section 18 T. 23 R. 34E W.M.
Bearing and distance from section or subdivision corner

(12) WELL LOG:


Diameter of well below casing

Depth drilled 70 ft. Depth of completed well 60 ft.

Formation: Describe color, texture, grain size and structure of materials;
and show thickness and nature of each stratum and aquifer penetrated,
with at least one entry for each change of formation. Report each change
in position of Static Water Level as drilling proceeds. Note drilling rates.

MATERIAL	From	To	SWL
TOP SOIL	0	8	
CLAY-GRAVEL MIX	8	30	
YELLOW CLAY	30	45	
FINE BROWN SAND	45	70	

NOTE WELL CONSTRUCTION

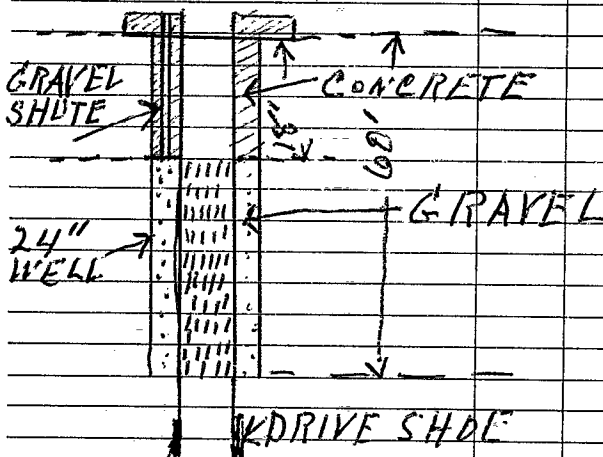

Work started 5-10-1970 Completed 8-11-1970
Date well drilling machine moved off of well 6-6-1970

Drilling Machine Operator's Certification:

This well was constructed under my direct supervision. Materials used and information reported above are true to my best knowledge and belief

[Signed] John W. Rossberg Date 8-11, 1970
(Drilling Machine Operator)

Drilling Machine Operator's License No. 2169

Water Well Contractor's Certification:

This well was drilled under my jurisdiction and this report is true to the best of my knowledge and belief.

NAME JOHN W. ROSSBERG
(Person, firm or corporation) (Type or print)

Address PO Box 639 CRANE OREG.

[Signed] John W. Rossberg
(Water Well Contractor)

Contractor's License No. 222 Date 8-11-1970