

STATE ENGINEER
Salem, Oregon

Well Record

STATE WELL NO. 24/30-2B1
COUNTY Harney
APPLICATION NO. G-1061

Harn 802

OWNER: John P. Fay

MAILING

ADDRESS:

P. O. Box 642

CITY AND

STATE:


Burns, Oregon

LOCATION OF WELL: Owner's No. 3

NW 1/4 NE 1/4 Sec. 2 T. 24 N. S. R. 30 E. W.M.

Bearing and distance from section or subdivision

corner 510' E. & 980' S. from NW cor.

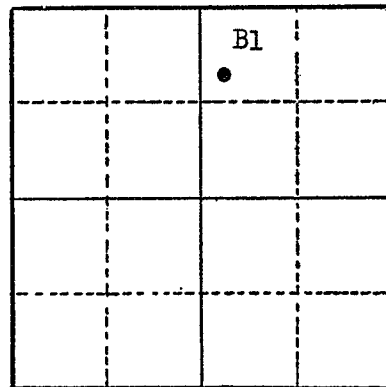

Section 2

Altitude at well

TYPE OF WELL: Drilled Date Constructed

Depth drilled 150 Depth cased

CASING RECORD:

FINISH:

AQUIFERS:

WATER LEVEL:

4 feet

PUMPING EQUIPMENT: Type H.P.
Capacity G.P.M.

WELL TESTS:

Drawdown ft. after hours G.P.M.

Drawdown ft. after hours G.P.M.

USE OF WATER Irrigation Temp. °F. 19

SOURCE OF INFORMATION G-1061

DRILLER or DIGGER

ADDITIONAL DATA:

Log Water Level Measurements Chemical Analysis Aquifer Test

REMARKS: