

STATE ENGINEER
Salem, Oregon

Well Record

STATE WELL NO. 24/30-2G(1)
COUNTY Harney
APPLICATION NO. G-1061

OWNER: John P. Fay

MAILING
ADDRESS:

P. O. Box 642

LOCATION OF WELL: Owner's No. 2


CITY AND
STATE:

Burns, Oregon

SW $\frac{1}{4}$ NE $\frac{1}{4}$ Sec. 2 T. 24 N. S., R. 30 W., W.M.

Bearing and distance from section or subdivision

corner 1526' S & 510' E from NW cor.

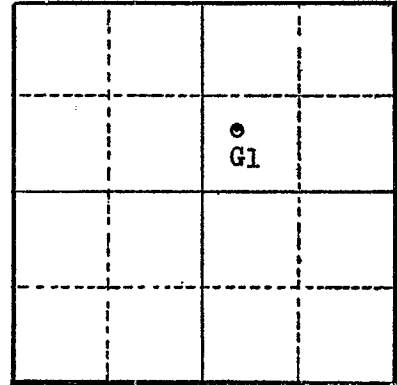

Altitude at well

TYPE OF WELL: Drilled Date Constructed

Depth drilled 150 Depth cased

Section 2

CASING RECORD:

FINISH:

AQUIFERS:

WATER LEVEL:

PUMPING EQUIPMENT: Type H.P.
Capacity G.P.M.

WELL TESTS:

Drawdown ft. after hours G.P.M.

Drawdown ft. after hours G.P.M.

USE OF WATER Irrigation Temp. °F., 19.

SOURCE OF INFORMATION G-1061 Permit G-977

DRILLER or DIGGER

ADDITIONAL DATA:

Log Water Level Measurements Chemical Analysis Aquifer Test

REMARKS: