

STATE ENGINEER
Salem, Oregon

Harn
095
Well Record

STATE WELL NO. 22/31-22 ~~1~~
COUNTY Harney
APPLICATION NO. G-189

OWNER: C. W. Clemens

MAILING
ADDRESS: _____

LOCATION OF WELL: Owner's No. 1


CITY AND
STATE: _____

Burns, Oregon

SW $\frac{1}{4}$ NW $\frac{1}{4}$ Sec. 22 T. 22 S., R. 31 E, W.M.

Bearing and distance from section or subdivision

corner 21' E. from SW cor. Sec. 22, T. 22 S.,
R. 31 E. Well N. 23° 50' E. 2830' from
initial point

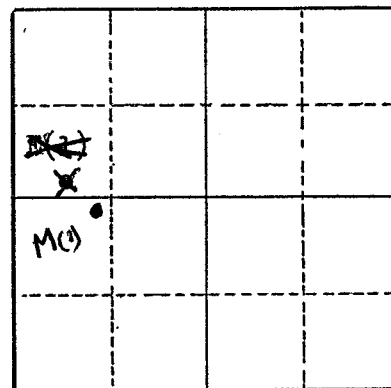

Altitude at well _____

TYPE OF WELL: Drilled Date Constructed July 1955

Depth drilled 242' Depth cased 131'

Section 22

CASING RECORD:

12-inch casing set from 0 to 131 feet

FINISH:

none

AQUIFERS:

"Basalt" from 130' to 242'. Water at 210' to 240'

WATER LEVEL:

PUMPING EQUIPMENT: Type _____ H.P. _____
Capacity _____ G.P.M.

WELL TESTS:

Drawdown _____ ft. after _____ hours _____ G.P.M.

Drawdown _____ ft. after _____ hours _____ G.P.M.

USE OF WATER Irrigation Temp. _____ °F. _____, 19_____

SOURCE OF INFORMATION Drillers report

DRILLER or DIGGER H. Baird License #42

ADDITIONAL DATA:

Log x Water Level Measurements _____ Chemical Analysis _____ Aquifer Test _____

REMARKS:

State Well No. 22/31-22^M(1)
County Harney
Application No. G-189

Owner: C. W. Clemens Owner's No. 1

Driller: H. Baird License #42 Date Drilled July 1955

[illegible]