

STATE ENGINEER
Salem, Oregon

HOOD Well Record

STATE WELL NO. 2N/10-26K(1)
COUNTY Hood River
APPLICATION NO. U-662

437

OWNER: Stadelman Fruit Co.


MAILING ADDRESS: P. O. Box 577

LOCATION OF WELL: Owner's No. _____

CITY AND STATE: Hood River, Oregon

NW $\frac{1}{4}$ SE $\frac{1}{4}$ Sec. 26 T. 2 N. S., R. 10 E. W., W.M.

Bearing and distance from section or subdivision corner _____

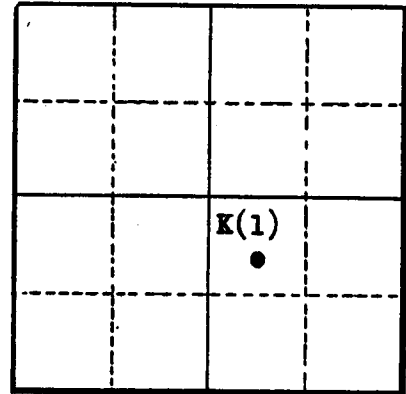

Section 26

Altitude at well _____

TYPE OF WELL: Drilled Date Constructed 8-53

Depth drilled 264 Depth cased 44

CASING RECORD:

8-inch, set to 44'

FINISH:

AQUIFERS:

WATER LEVEL:

At land surface 1953

PUMPING EQUIPMENT: Type Turbine H.P. 20
Capacity _____ G.P.M.

WELL TESTS:

Drawdown to 205 ft. after _____ hours 200 G.P.M.

Drawdown _____ ft. after _____ hours _____ G.P.M.

USE OF WATER Irrigation Temp. 51 °F. August, 19 53

SOURCE OF INFORMATION U-662

DRILLER or DIGGER Courtney Back-Yakima

ADDITIONAL DATA:

Log Water Level Measurements _____ Chemical Analysis _____ Aquifer Test _____

REMARKS:

