

HOOD 51073

STATE OF OREGON WATER SUPPLY WELL REPORT

(as required by ORS 537.765)

Instructions for completing this report are on the last page of this form.

WELL I.D. # L 109620

START CARD # 1037685

Hood 51073

(1) LAND OWNER Well Number TW3
Name Nestle Corp /Pacific Groundwater
Address 2377 East Lake Ave.
City Seattle State Wa Zip 98102

(2) TYPE OF WORK
☐ New Well ☐ Deepening ☐ Alteration (repair/recondition) ☒ Abandonment

(3) DRILL METHOD:
☒ Rotary Air ☐ Rotary Mud ☐ Cable ☐ Auger
☐ Other

(4) PROPOSED USE:
☐ Domestic ☐ Community ☒ Industrial ☐ Irrigation
☐ Thermal ☐ Injection ☐ Livestock ☒ Other Test well

(5) BORE HOLE CONSTRUCTION:
Special Construction approval ☐ Yes ☐ No Depth of Completed Well _____ ft.
Explosives used ☐ Yes ☐ No Type _____ Amount _____

HOLE			SEAL			Sacks or pounds
Diameter	From	To	Material	From	To	
			Cement w/ 0		137	3055 lbs
			4% Bentonite			
			calculated			2820 lbs

How was seal placed: Method ☐ A ☐ B ☐ C ☐ D ☐ E
☐ Other

Backfill placed from _____ ft. to _____ ft. Material _____
Gravel placed from _____ ft. to _____ ft. Size of gravel _____

(6) CASING/LINER:

	Diameter	From	To	Gauge	Steel	Plastic	Welded	Threaded
Casing:					☐	☐	☐	☐
					☐	☐	☐	☐
					☐	☐	☐	☐
					☐	☐	☐	☐
Liner:					☐	☐	☐	☐
					☐	☐	☐	☐

Drive Shoe used ☐ Inside ☐ Outside ☐ None
Final location of shoe(s) _____

(7) PERFORATIONS/SCREENS:

From	To	Slot size	Number	Diameter	Tele/pipe size	Casing	Liner
						☐	☐
						☐	☐
						☐	☐
						☐	☐

(8) WELL TESTS: Minimum testing time is 1 hour

Yield gal/min	Drawdown	Drill stem at	Time
			1 hr.

Temperature of water _____ Depth Artesian Flow Found _____
Was a water analysis done? ☐ Yes By whom _____
Did any strata contain water not suitable for intended use? ☐ Too little
☐ Salty ☐ Muddy ☐ Odor ☐ Colored ☐ Other _____
Depth of strata: _____

(9) LOCATION OF WELL by legal description:
County Hood River Latitude _____ Longitude _____
Township 2 N N or S Range 8E E or W. WM.
Section 5 NE 1/4 SW 1/4
Tax Lot 302 Lot _____ Block _____ Subdivision _____
Street Address of Well (or nearest address) O Cramblett Way
Cascade Locks

(10) STATIC WATER LEVEL:
40'9 ft. below land surface. Date 4-19-18
Artesian pressure _____ lb. per square inch Date _____

(11) WATER BEARING ZONES:
Depth at which water was first found _____

From	To	Estimated Flow Rate	SWL

(12) WELL LOG:
Ground Elevation _____

Material	From	To	SWL
Abandoned 6" well 137 ft deep, used 4" mills Knife in 4" screen Section spacer			
4 rows 114 ft to 128'			
Perforated 6" casing			
4 rows Star Perforator			
perfs. from 0 - 110 ft top of screen			
Pressure grouted with Portland Cement 137 ft to land surface cut off 6" casing 3 ft below grade.			


Date started 4-19-18 Completed 4-19-18

(unbonded) Water Well Constructor Certification:
I certify that the work I performed on the construction, alteration, or abandonment of this well is in compliance with Oregon water supply well construction standards. Materials used and information reported above are true to the best of my knowledge and belief. Mark Blackburn
Signed Mark Blackburn WWC Number 1920 Date 4-22-18

(bonded) Water Well Constructor Certification:
I accept responsibility for the construction, alteration, or abandonment work performed on this well during the construction dates reported above. All work performed during this time is in compliance with Oregon water supply well construction standards. This report is true to the best of my knowledge and belief.
Ron Aspaas WWC Number 1445
Signed Ron Aspaas Date 4-22-18

HOOD 51073

HOOD 50851

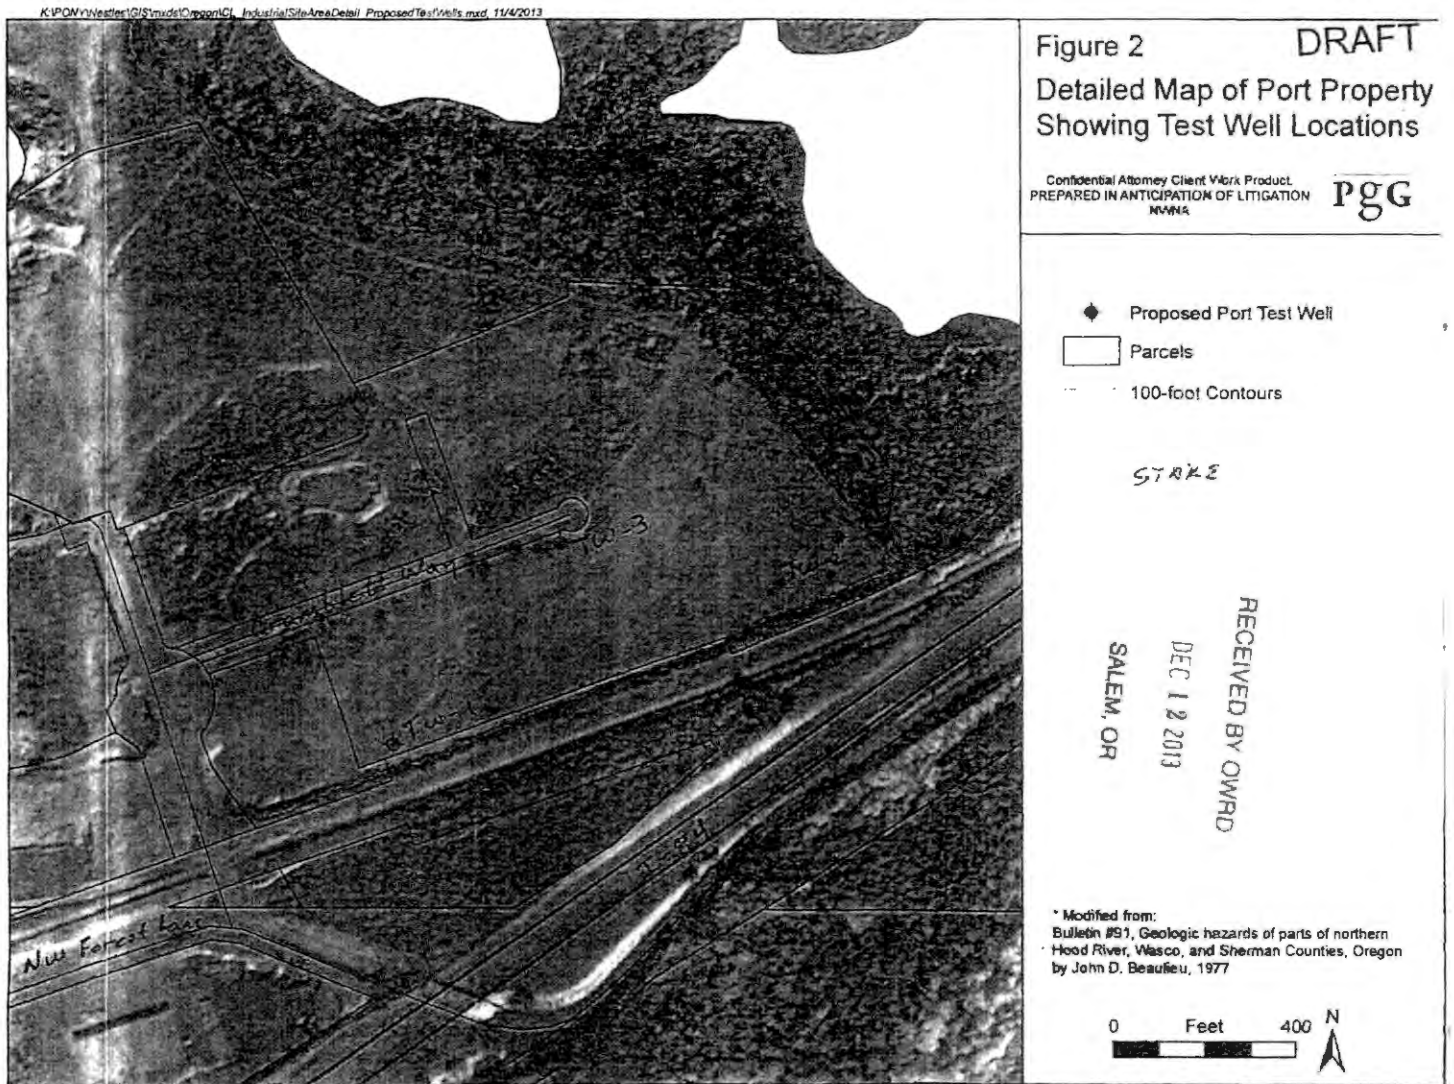

RECEIVED

MAY 29 2018

OWRD