

STATE OF OREGON
WATER SUPPLY WELL REPORT
(as required by ORS 537.765)

Instructions for completing this report are on the last page of this form.

Hood 51074

(1) LAND OWNER Well Number TW 2
Name Nestle Corp/Pacific Groundwater
Address 2377 Easr Lake Ave
City Sealte State Wa Zip 98102

(2) TYPE OF WORK
☐ New Well ☐ Deepening ☐ Alteration (repair/recondition) ☒ Abandonment

(3) DRILL METHOD:

☒ Rotary Air ☐ Rotary Mud ☐ Cable ☐ Auger

☐ Other _____

(4) PROPOSED USE:

☐ Domestic ☐ Community ☒ Industrial ☐ Irrigation

☐ Thermal ☐ Injection ☐ Livestock ☒ Other TEST well

(5) BORE HOLE CONSTRUCTION:
Special Construction approval ☐ Yes ☐ No Depth of Completed Well _____ ft.
Explosives used ☐ Yes ☐ No Type _____ Amount _____

HOLE			SEAL			
Diameter	From	To	Material	From	To	Sacks or pounds
			Cement	0	73	2914 lbs
			24%Bentonite			
			calculated			1410 lbs

How was seal placed: Method ☐ A ☐ B ☐ C ☐ D ☐ E
☐ Other _____

Backfill placed from _____ ft. to _____ ft. Material _____
Gravel placed from _____ ft. to _____ ft. Size of gravel _____

(6) CASING/LINER:

	Diameter	From	To	Gauge	Steel	Plastic	Welded	Threaded
Casing:					☐	☐	☐	☐
					☐	☐	☐	☐
					☐	☐	☐	☐
					☐	☐	☐	☐
Liner:					☐	☐	☐	☐
					☐	☐	☐	☐

Drive Shoe used ☐ Inside ☐ Outside ☐ None
Final location of shoe(s) _____

(7) PERFORATIONS/SCREENS:

☐ Perforations Method _____

☐ Screens Type _____ Material _____

From	To	Slot size	Number	Diameter	Tele/pipe size	Casing	Liner
						☐	☐
						☐	☐
						☐	☐
						☐	☐

(8) WELL TESTS: Minimum testing time is 1 hour

☐ Pump Yield gal/min	☐ Bailer Drawdown	☐ Air Drill stem at	☐ Flowing Artesian Time 1 hr.

Temperature of water _____ Depth Artesian Flow Found _____

Was a water analysis done? ☐ Yes By whom _____

Did any strata contain water not suitable for intended use? ☐ Too little

☐ Salty ☐ Muddy ☐ Odor ☐ Colored ☐ Other _____

Depth of strata: _____

(9) LOCATION OF WELL by legal description:

County Hood River Latitude _____ Longitude _____

Township 2N N or S Range 8 E E or W. WM.

Section 5 NE 1/4 SW 1/4

Tax Lot	Lot	Block	Subdivision
---------	-----	-------	-------------

Street Address of Well (or nearest address) 0 Gramble Hwy

Street Address or Well (or nearest address) 6 Clamble Way
Cascade Lock

(10) STATIC WATER LEVEL:

40'2 ft. below land surface. Date 4-18-18

Artesian pressure _____ lb. per square inch Date _____

(11) WATER BEARING ZONES:

Depth at which water was first found _____

From	To	Estimated Flow Rate	SWL

(12) WELL LOG:

Ground Elevation _____[illegible]

Date started 4-19-18 Completed 4-19-18

(unbonded) Water Well Constructor Certification:

I certify that the work I performed on the construction, alteration, or abandonment of this well is in compliance with Oregon water supply well construction standards. Materials used and information reported above are true to the best of my knowledge and belief.

knowledge and belief. Mark Blackburn WWC Number 1920
Signed Mark Blackburn Date 4-24-18


(bonded) Water Well Constructor Certification:

I accept responsibility for the construction, alteration, or abandonment work performed on this well during the construction dates reported above. All work performed during this time is in compliance with Oregon water supply well construction standards. This report is true to the best of my knowledge and belief.

Ron Aspaas WWC Number 1445
Signed  Date 4-24-18

HOOD 51074

HOOD 50850

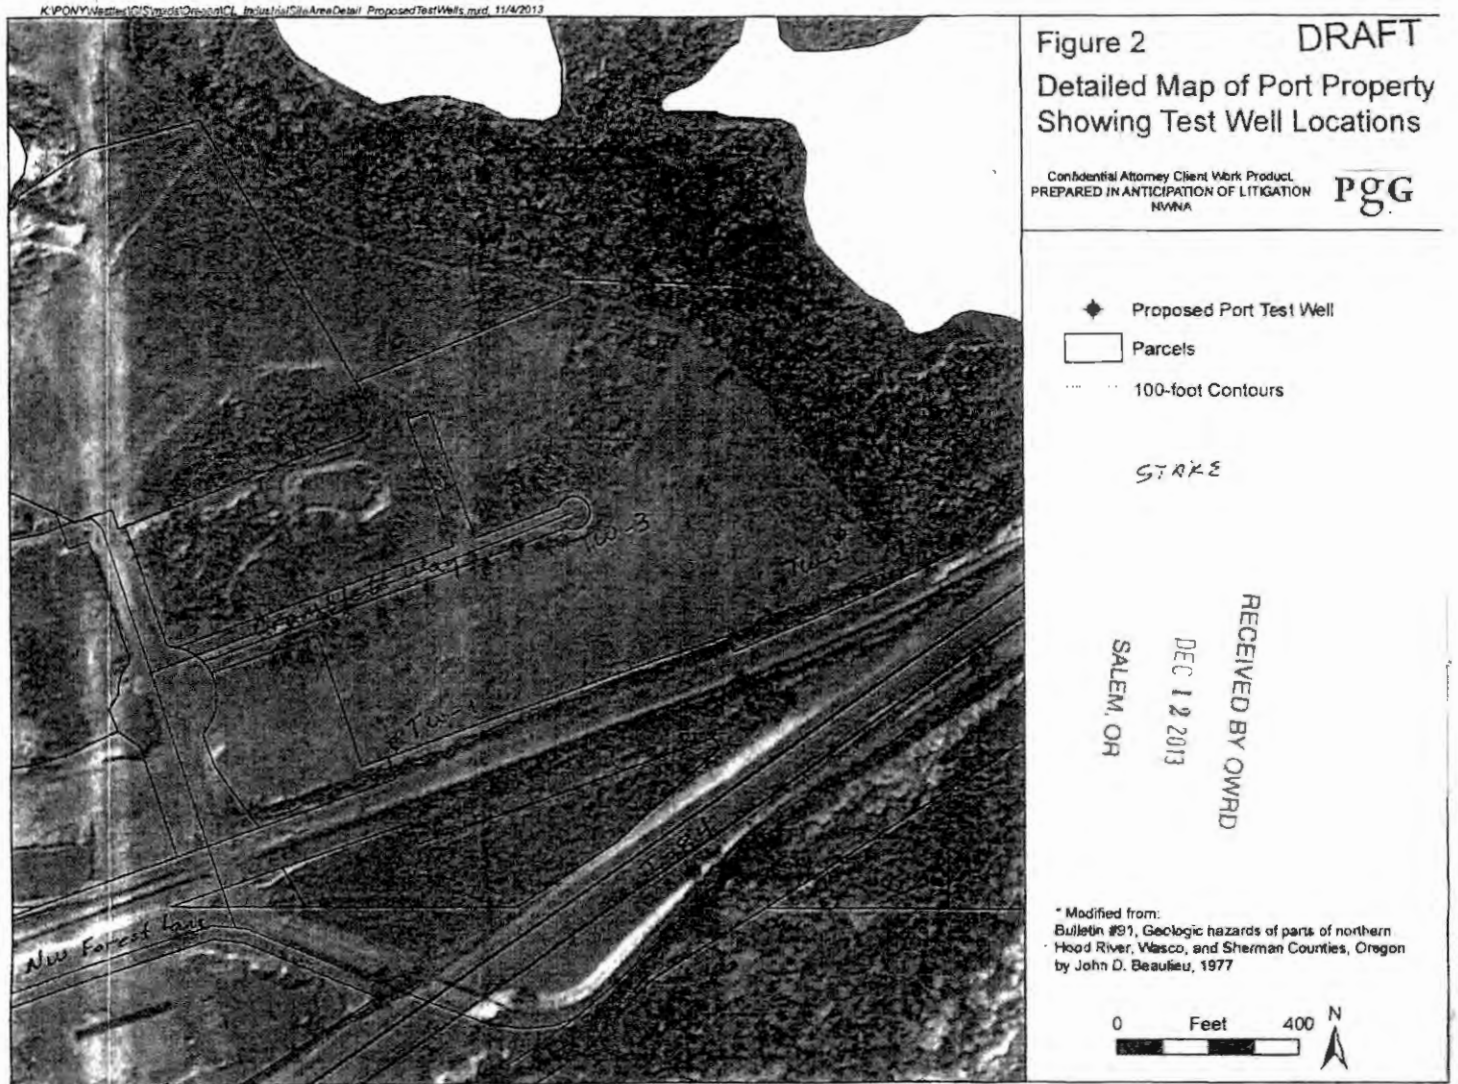

RECEIVED

MAY 29 2018

OWRD