


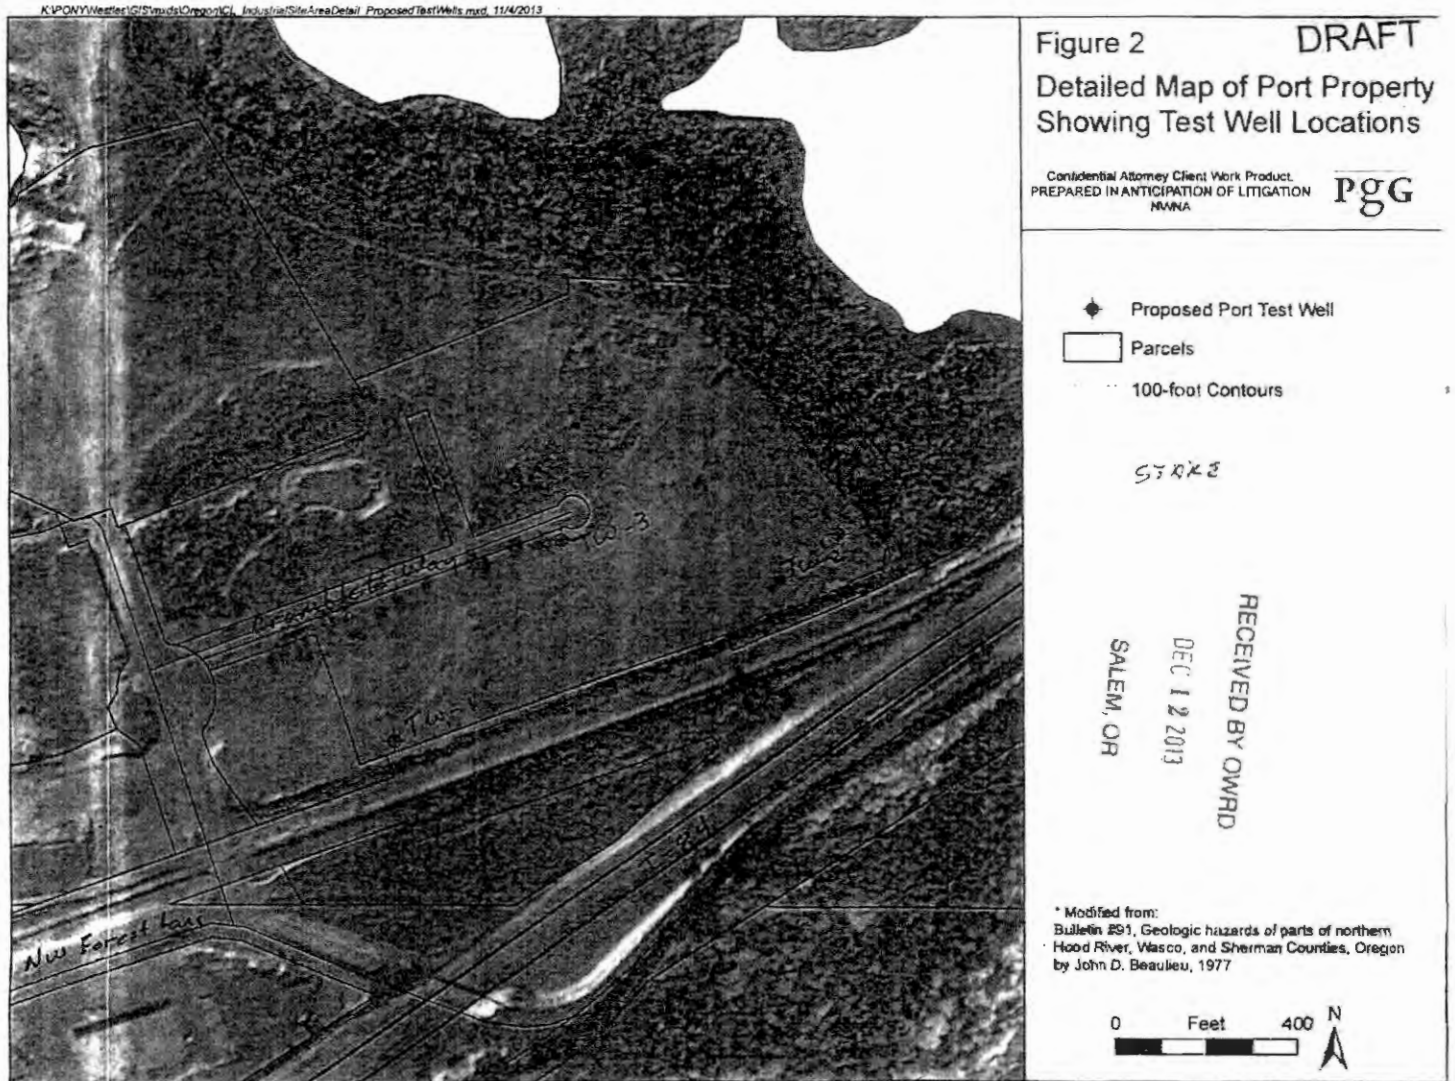

HOOD 51078

HOOD 50849



RECEIVED

MAY 29 2018

OWRD