

Cooper Spur Inn


25/10E-6db

RECEIVED

DEC 13 1979

WATER RESOURCES DEPT
SALEM, OREGON

A. EXISTING WELL

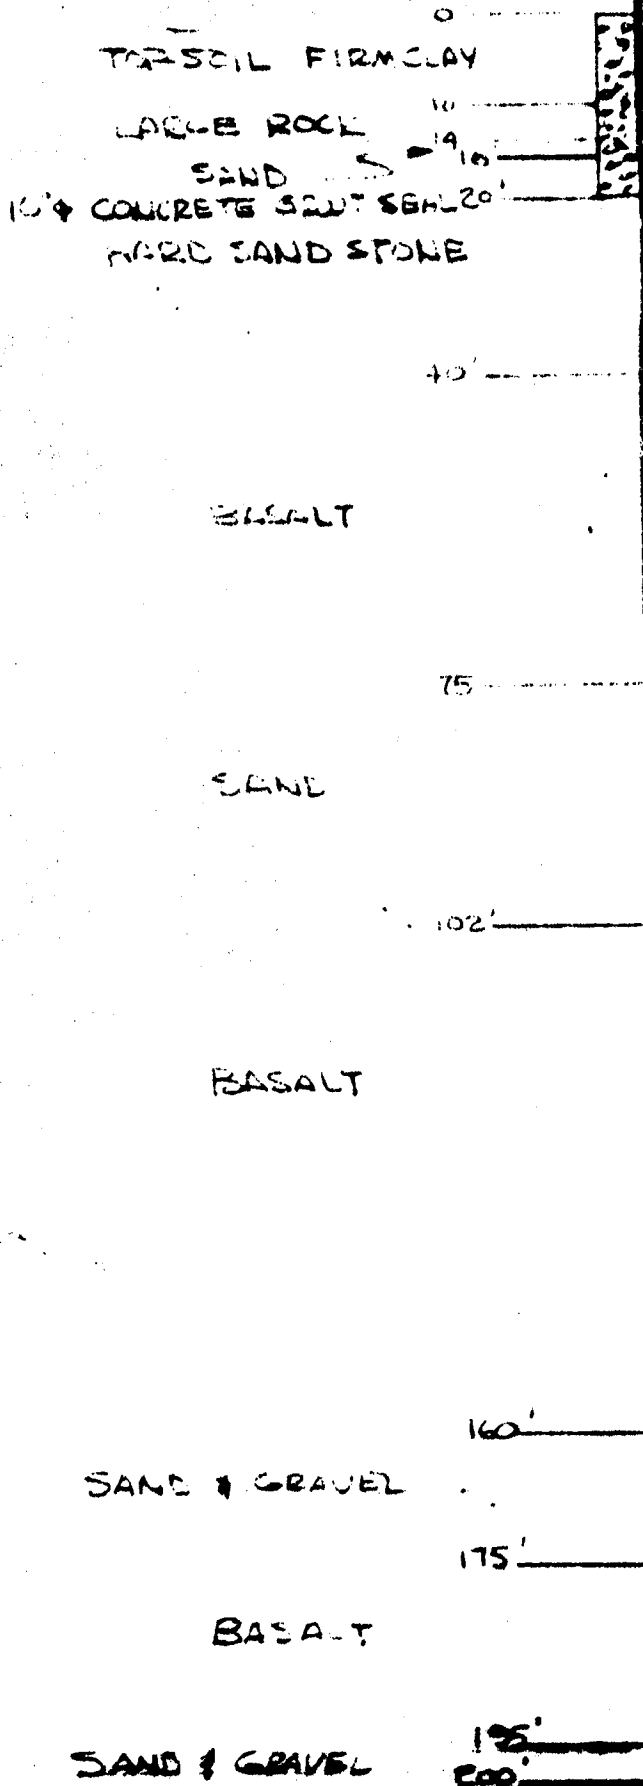

B. CORRECTIONS

0' GROUND LEVEL

10" ϕ BORE HOLE OVER
EXISTING 6" ϕ X .250 WALL
CASING X 40' TO IMPERVIOUS
BASALT LAYER. PRESSURE
GROUT TO GROUND LEVEL
TO SEAL.

BACK BASALT 35'-40'

40'
10" ϕ

NOTE: WELL CASING NEW
3-7-79 6in ID X.250
+ 2' TO 85'

SWL 58'

OWNER: DAN DILLARD
COOPER SPUR, OR
CONTRACTOR: A.M. JANNSEN
WELL DRILLING CO.
ALOHA, OR
OPERATOR: PRESTON JANNSEN

WORK PERFORMED:
DEC. 13-14, 1979

* on site inspection by personnel of
WATER RESOURCES DEPT
HOOVER COUNTY SANITARIA
COOPER SPUR INN

FW @ 173

TALBOTT WONG & ASSOC. INC.
PORTLAND OREGON

DAN DILLARD
COOPER SPUR INN
WELL RECONDITIONING PROPOSAL

DES	DATE	SCALE	NAME
DR	12/13/79	DRAWING NO.	1215

RECEIVED

FROM WATER RESOURCES DEPARTMENT
DAM SAFETY & WELLS DIVISION
555 13th Street N. E.
SALEM, OREGON 97310
PHONE (503) 378-8455

TO: WATER RESOURCES DEPT
SALEM, OREGON

DEC 13 1979

SUBJECT:
FOLD

Cooper Spur well repair as directed

DATE: Dec. 14, 1979

STATE WELL NO. 25/DE-6db

4in dia. annular bore drilled over existing 6in.
CASING TO 40'± 5' into hard grey-black basalt
* Gravel backfill in annular bore returned to 40'

It is permitted by the WRD "STANDARDS FOR WATER
WELL CONSTRUCTION" THAT A GRAVEL PACK WELL,
without surface casing, shall have a 4in annular bore
greater than the nominal dia. of the permanent casing.

PLEASE REPLY TO →

SIGNED

[Handwritten Signature]

A. M. Jensen, Well Division

Chr. # 79

DATE

12/14/79

SIGNED

[Handwritten Signature]

WRD