

STATE ENGINEER
Salem, Oregon

Jack
11777

Well Record

STATE WELL NO. 37/LW-19
COUNTY JACKSON
APPLICATION NO. GR-2603

OWNER: Jesse R. Ellis


MAILING ADDRESS: 1462 Poplar Drive

LOCATION OF WELL: Owner's No. _____

CITY AND STATE: Medford, Oregon

1/4 1/4 Sec. 19 T. 37 N. S., R. 1 E. W., W.M.

Bearing and distance from section or subdivision corner Within city limits of Medford, Oregon

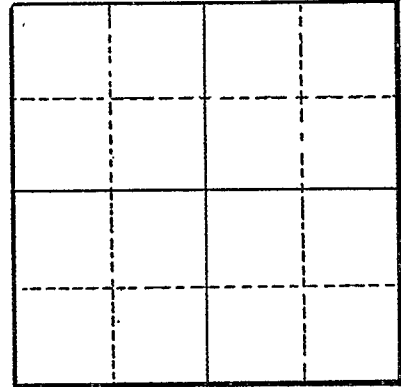

Section _____

Altitude at well _____

TYPE OF WELL: Dug Date Constructed 1953

Depth drilled 12 Depth cased 12

CASING RECORD:

6-inch
36-inch

FINISH:

8 1/2 perforations per foot. (Est.) from 8' to 12'

AQUIFERS:

Topsoil, clay loam and gravel

WATER LEVEL:

2.0-feet

PUMPING EQUIPMENT: Type Carver Centrifugal H.P. 1 1/2
Capacity 80 G.P.M.

WELL TESTS:
Drawdown 10 ft. after _____ hours Pumping 40 G.P.M.
Drawdown _____ ft. after _____ hours _____ G.P.M.

USE OF WATER Irrigation Temp. _____ °F. _____, 19

SOURCE OF INFORMATION GR-2470
DRILLER or DIGGER City Sanitation Service, Medford, Oregon

ADDITIONAL DATA:
Log Water Level Measurements _____ Chemical Analysis _____ Aquifer Test _____

REMARKS:

Topsoil (Black Clay Loam) 11 1
Medium Gravel 1 0