

STATE ENGINEER  
Salem, Oregon

*well*  
*11778*

# Well Record

BR- 1594


STATE WELL NO. 37/1W-192  
COUNTY Jackson  
APPLICATION NO. GR- 1611

OWNER: Eric & Lee Verne de Place MAILING ADDRESS: 1392 Poplar Drive

LOCATION OF WELL: Owner's No. \_\_\_\_\_ CITY AND STATE: Medford, Oregon

NE  $\frac{1}{4}$  NW  $\frac{1}{4}$  Sec. 19 T. 37 S., R. 1 W., W.M.

Bearing and distance from section or subdivision corner See spotting of well on map

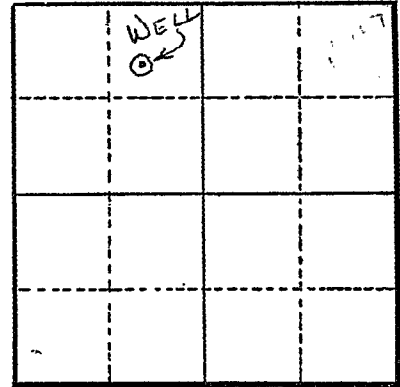

Section 19

Altitude at well 1382'

TYPE OF WELL: Dug Date Constructed 1945

Depth drilled 9.5' Depth cased 9.5'

### CASING RECORD:

- 6" tile from 0 to 6.5 ft.
- 2- 36" perforated tiles from 6.5 to 9.5 ft.

### FINISH:

36" tiles are perforated

### AQUIFERS:

### WATER LEVEL:

- 1.5' in Spring
- 7.5' in Fall

PUMPING EQUIPMENT: Type Bilton Type LL H.P. 1  
Capacity 25 G.P.M.

### WELL TESTS:

Drawdown \_\_\_\_\_ ft. after \_\_\_\_\_ hours \_\_\_\_\_ G.P.M.  
Drawdown \_\_\_\_\_ ft. after \_\_\_\_\_ hours \_\_\_\_\_ G.P.M.

USE OF WATER Irrigation Temp. \_\_\_\_\_ °F. \_\_\_\_\_, 19\_\_\_\_\_

SOURCE OF INFORMATION GR Record

DRILLER or DIGGER \_\_\_\_\_

### ADDITIONAL DATA:

Log \_\_\_\_\_ Water Level Measurements \_\_\_\_\_ Chemical Analysis \_\_\_\_\_ Aquifer Test \_\_\_\_\_

### REMARKS:

Log: Soil 0 to 8.5 ft.  
Gravel 8.5 to 9.5 ft. At this level digging was stopped because of water.  
Irrigation of 1.75 acres.