STATE OF OREGON JACK

Artesian

Time

1 hr.

Bailer

Drawdown

¥

~

Air

Drill stem at

199

Depth Artesian Flow Found

NEGENEU

Pump

Yield gal/min

7.5

Temperature of, water

Was a water analysis done?

STATE OF OREGON JACK	JACK 1	4487			card # 00)'/⊥
(as required by ORS 537.765)		MAY 1 3 198		<u> 385/</u>	1W-2	deep
		V(9) LOCATION	OF WEIL by l	egal des	cription:	
Name Fern Valley Improvement Dist	trict	Gounty EMLackso	n Latitude	<u> </u>	ongitude	, ,
Address P.O. BOX 982	*	Township 385	N or S, Range1	W	E or W	, WM.
City Phoenix State Or	Zip 975535	Section 2	¼		- 1/4	
(2) TYPE OF WORK:	· · · ·	Tax Lot	Lot Bloc	k		
New Well 🖈 Deepen 🗌 Recondition	Abandon	Street Address of Well	(or nearest address) _			
(3) DRILL METHOD	the second se	<u>2715 Payne</u>	Road Phoe	nix (ne	<u>ext door)</u>	
Rotary Air Rotary Mud Cable		(10) STATIC WA	TER LEVEL	:	i - 1	
Other			ow land surface.		Date4_;	<u>25-88</u>
(4) PROPOSED USE:		Artesian pressure		are inch.		
🙀 Domestic 🔲 Community 🗌 Industrial 🗌	0	(11) WATER BE	ARING ZONI			
Thermal Injection Other			210	101	•	
(5) BORE HOLE CONSTRUCTION:		Depth at which water was fi	rst found			
s Al Construction approval Yes No Depth of Co	ompleted Well ft.	From	To	1	ted Flow Rate	SWL
Yes No لے لے xplosives used	5 Nunt	140	145	<u> </u>	7. 5	~28 [~]
HOLE SEAL Diameter From To Material From	Amount To sacks or pounds					
					· · ·	
		(12) WELL LOG	Ground elevat	ion	4	
			aterial ,		From To	SWL
		siltstone, b			100 140	_
How was seal placed: Method 🔲 A 🗍 B 🗍 C		· -	urple		140 185	28
□ Other		sandstone, g	rey		185 200	
Backfill placed from ft. to ft. Material				T.		
Gravel placed from ft. to ft. Size of gra	avel	<u> </u>		·		
(6) CASING/LINER:		<u> </u>				
Diameter From To Gauge Steel Place		casing and	eeal undistu	irhed		
Casing:		CODILIE CILL	DOGT UNGTO			1
						1
Liner: 4" 0 200 .250						
			· · · · ·			
Final location of shoe(s)						1
PERFORATIONS/SCREENS:			· · · · · · · · · · · · · · · · · · ·			
· _						
	aterial					
Slot Tele/p						
wrom To size Number Diameter size						
					17 17	
					<u>, , , , , , , , , , , , , , , , , , , </u>	
		Date started 4-21-8	38 Con	pleted	4-25-88	
		(unbonded) Water We	ll Constructor Ce	rtificatio	n:	
(8) WELL TESTS: Minimum testing tim	e is 1 hour	I certify that the value of this w	work I performed o	on the con	struction, alte	

abandonment of this well is in compliance with Oregon well construction standards. Materials used and information reported above are true to my best knowledge and belief.

WWC Number Signed Date

(bonded) Water Well Constructor Certification:

I accept responsibility for the construction, alteration, or abandonment
work performed on this well during the construction dates reported above. all
work performed during this time is in compliance with Oregon well
construction standards. This report is true to the best of my knowledge and
belief. () 0 C, www.Number ± 77
Signed tom Studeballar Date 5-1-88

Did any strata contain water not suitable for intended use? 🔲 Too little
Salty Muddy Odor Colored Other
Depth of strata:
WHITE COPIES - WATER RESOURCES DEPARTMENT


Yes By whom

YELLOW COPY - CONSTRUCTOR

PINK COPY - CUSTOMER

9809C 10/86

JACK 14487

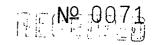

"START CARD" NOTICE OF BEGINNING OF WELL CONSTRUCTION (as required by ORS 537.762)

119A - 5 1869

WATER RESOURCES DEPT. SALED, OREGON

This form must be completed, signed by both the owner (or authorized agent) and constructor, and the original delivered to the Water Resources Department prior to commencement of construction, alteration or abandonment of each well.

Owner's Name and Mailing Address	Fern Valley Estates Improvement Districito PO Box 982 Phoenix OR 92535	
Proposed Commence	ement Date 98	
Proposed Well Depth	, Diameter,	
Domestic Thermal	Community □ Industrial □ Irrigation □ Injection	
Proposed Well Locati	on: County Jattson	
Township <u>3</u>	S(N or S) Range 1 ~ (E or W) Section 2	
At least 2 of these must be provided	 1 1/4 of 1/4 of above section 700' East & W. Line 200 norm & DLC stake # 87 2. street address of <u>next to Larry Bryants house</u> well location <u>at 2715 Payne Rf. Phoenix on</u> 3. tax lot number of well location 4. attach approved map with location identified. (see reverse of this form for approved maps) 	I
We hereby certify that	we have read the back of this form, and that to the best of our knowledge the information	

provided herein is accurate and the well is being properly located from septic tanks and septic drain fields.

(x hichoud Owner's Signature	X John Studeballer Bonded Water Well Constructor
<u>Freside</u> Title	License No. 679
<u>4-21-88</u> Date	Company Studebaker Driving Jus

Note: This is not a Water Right application. The owner is responsible for obtaining a Water Right through the Water Resources Department if required.



Oregon Water Resources Department 725 Summer Street NE, Suite A Salem Oregon 97301 (503) 986-0900 www.oregon.gov/owrd

Application for Well ID Number

		RECEIVE	D
Do not complete if the well already has a Well Identification Number.		OCT 1020	19
		OWRD	
I. <u>OWNER INFORMATION</u>			
Current Owner Name (please print): Fern Valley Estates Improvement District,	(Well No.6)		
Mailing Address: 2387 Terri Drive			
City, State, Zip: Medford, OR 97504			
Mail Well ID to: SAME AS ABOVE In Care Of (C/O)		э.	
Name & Address: Harold L. Center, President FVEID			
City, State, Zip: 2604 David Lane, Medford, OR 97504			
II. <u>WELL LOCATION INFORMATION</u> (Please fill out as completely as possible)			
Township: <u>38 South</u> (North / South) Range: <u>1 West</u> (East / West) Section: <u>2</u>		_ 1/4 of the SE	1/4
Tax Lot (usually last 3-5 numbers of Tax Map #): 1300 381W02DA Country	y Jackson		

GPS Coordinates: 42d 17' 29.39" N 122d 46' 46.15" W Street Address of Well, City: 2675 David Lane, Medford, Or 97504


If the property had a different street address in the past: P.O. Box 982, Phoenix OR

III. GENERAL WELL INFORMATION (Please fill out as completely as possible, AND attach copy of Well Report, if available) . . Domestic

Use of Well (domestic, irrigation, commercial, industrial, monitoring):
Date Well Constructed (or property built): 05/21/1966 Total Well Depth: 105* Casing Diameter: 6"
Owner at time the well was constructed (if known): Adamsville/FVEID Well Report # (if known): Jack 50633/14487
Other Information: * well deepen to 200', see Jack 14487
a MA
SUBMITTED BY (please print): Harold L. Center, President FVEID
EMAIL &/or FAX: center1071@gmail.com

Send application to: Oregon Water Resources Department 725 Summer St NE, Suite A, Salem, Oregon 97301; or fax to (503) 986-0902. Applications are processed in the order they are received, and Well ID Numbers are mailed within 4-5 business days.

Foi	Official Use Only by the Oregon Water Resources Departme	nt:
Received Date:	Well Report Number: JACK 50633 + JACK 14487	Well Identification #: L-135929
	-ORIG - DEEPENED -	

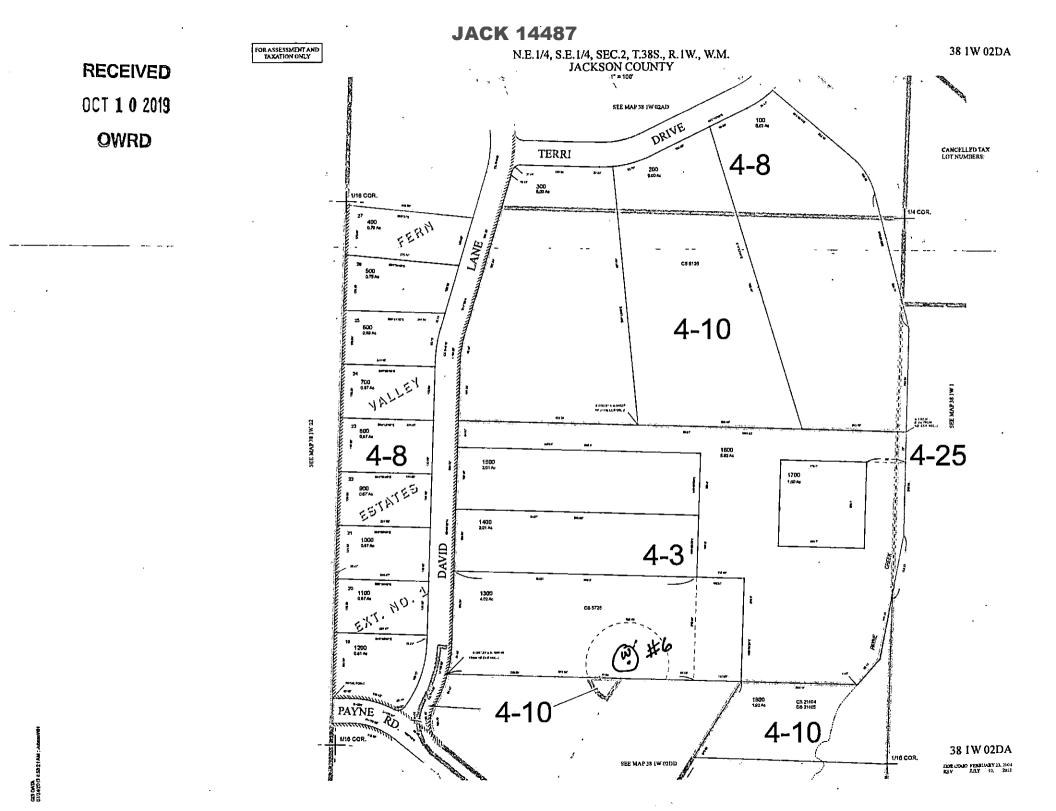

JACK 14487

STATE OF OREGON WELL LOCATION MAP

This map is supplemental to the WATER SUPPLY WELL REPORT

LOCATION OF WELL

Latitude: 42.29149722 Datum: WGS84 Longitude: -122.77948611

Township/Range/Section/Quarter-Quarter Section: WM 38S 1W 2 NESE Address of Well:

2675 DAVID LN

Oregon Water Resources Department

725 Summer St NE, Salem OR 97301 (503)986-0900



Well Label: L135929 Well Log: JACK 14487 Printed: October 16, 2019

DISCLAIMER: This map is intended to represent the approximate location of the well as provided by the land owner, well driller or OWRD staff. It is not intended to be construed as survey accurate in any manner.

Generated by OWRD

