

STATE ENGINEER
Salem, Oregon

Jack
15996 Well Record

STATE WELL NO. 38/2W-2H
COUNTY Jackson
APPLICATION NO. GR-3362

OWNER: Chester Fraker


MAILING ADDRESS: 1361 Kings Highway

LOCATION OF WELL: Owner's No. _____

CITY AND STATE: Medford, Oregon

SW $\frac{1}{4}$ SE $\frac{1}{4}$ NE $\frac{1}{4}$ Sec. 2 T. 38 N. S. R. 2 W., W.M.

Bearing and distance from section or subdivision corner 1404' N. and 652' W.

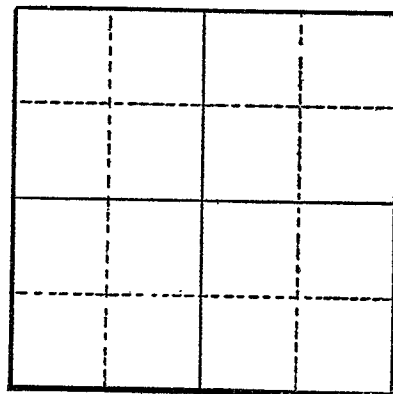

Section _____

Altitude at well _____

TYPE OF WELL: dug Date Constructed 1948

Depth drilled 12' Depth cased 12'

CASING RECORD:

4' x 4'

FINISH:

AQUIFERS:

top soil medium gravel

WATER LEVEL:

3'

PUMPING EQUIPMENT: Type Masters Centrifugal

H.P. 2

Capacity 40 G.P.M.

WELL TESTS:

Drawdown _____ ft. after _____ hours _____ G.P.M.

Drawdown _____ ft. after _____ hours _____ G.P.M.

USE OF WATER Irrigation Temp. _____ °F., 19 _____

SOURCE OF INFORMATION GR- 3113

DRILLER or DIGGER _____

ADDITIONAL DATA:

Log X Water Level Measurements _____ Chemical Analysis _____ Aquifer Test _____

REMARKS:

free top soil 6 6
medium gravel (water bearing) 6 0