

STATE ENGINEER
Salem, Oregon


Jack
16111
Well Record

STATE WELL NO. 38 / 2W - 5E
COUNTY JACKSON
APPLICATION NO. GR-1957

OWNER: Thurl W. Moore MAILING ADDRESS: P. O. Box 332
CITY AND STATE: Jacksonville, Oregon

LOCATION OF WELL: Owner's No. _____
SW $\frac{1}{4}$ NW $\frac{1}{4}$ Sec. 5 T. 38 N. S., R. 2 E. W., W.M.

Bearing and distance from section or subdivision
corner 590' N. of 215' E. of the $\frac{1}{4}$ corner

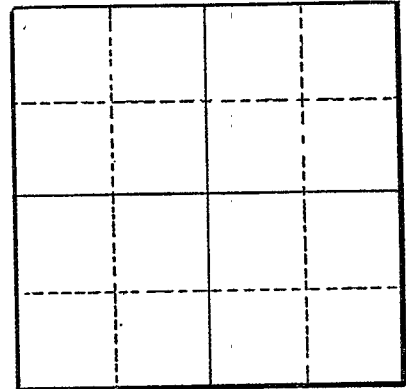

Altitude at well _____

TYPE OF WELL: Dug Date Constructed 1932

Depth drilled 42 Depth cased _____

Section _____

CASING RECORD:

FINISH:

AQUIFERS:

Clay

WATER LEVEL:

8

PUMPING EQUIPMENT: Type Centrifugal pump H.P. 50
Capacity 100 G.P.M.

WELL TESTS:
Drawdown 7 ft. after _____ hours pumping 15 G.P.M.
Drawdown _____ ft. after _____ hours _____ G.P.M.

USE OF WATER Irrigation Temp. _____ °F. _____, 19. _____

SOURCE OF INFORMATION GR-1883

DRILLER or DIGGER _____

ADDITIONAL DATA:

Log X Water Level Measurements _____ Chemical Analysis _____ Aquifer Test _____

REMARKS:

Clay

42 to 42