

STATE ENGINEER
Salem, Oregon

Jack
16324

Well Record

STATE WELL NO. 38/2W-10K(1)
COUNTY Jackson
APPLICATION NO. GR-541

OWNER: Loren D. Groucher


MAILING ADDRESS: Route 1, Box 377C

LOCATION OF WELL: Owner's No. _____

CITY AND STATE: Medford, Oregon

NW 1/4 SE 1/4 Sec. 10 T. 38 N. S. R. 2 E. W., W.M.

Bearing and distance from section or subdivision
corner 150' S. & 340' W. from NW cor. DLC 48

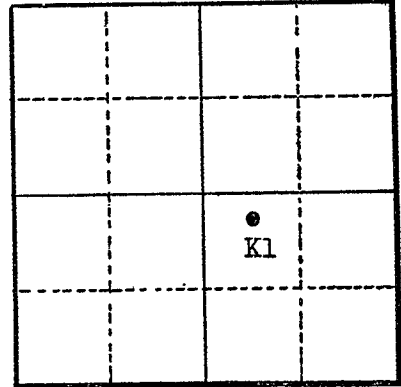

Section 10

Altitude at well 1760

TYPE OF WELL: Dug Date Constructed Aug '54

Depth drilled 13 Depth cased _____

CASING RECORD:

Infiltration trench: 40' x 8' 10 to 13' deep

FINISH:

AQUIFERS:

WATER LEVEL:

4'

PUMPING EQUIPMENT: Type Centrifugal H.P. 3
Capacity _____ G.P.M.

WELL TESTS:

Drawdown _____ ft. after _____ hours _____ G.P.M.
Drawdown _____ ft. after _____ hours _____ G.P.M.

USE OF WATER Irrigation 2 acres Temp. _____ °F. _____, 19____

SOURCE OF INFORMATION GR-541

DRILLER or DIGGER _____

ADDITIONAL DATA:

Log _____ Water Level Measurements _____ Chemical Analysis _____ Aquifer Test _____

REMARKS: