

STATE ENGINEER
Salem, Oregon

Jack
16449

Well Record


STATE WELL NO. 38/2W-11
COUNTY JACKSON
APPLICATION NO. GR-2966

OWNER: Mrs. Sam R. Wier MAILING ADDRESS: Rt. 4, Box 375

LOCATION OF WELL: Owner's No. _____ CITY AND STATE: Medford, Oregon

NE $\frac{1}{4}$ NW $\frac{1}{4}$ SW $\frac{1}{4}$ Sec. 11 T. 38 S., R. 2 W., W.M.

Bearing and distance from section or subdivision corner 8' S. and 1002' E.

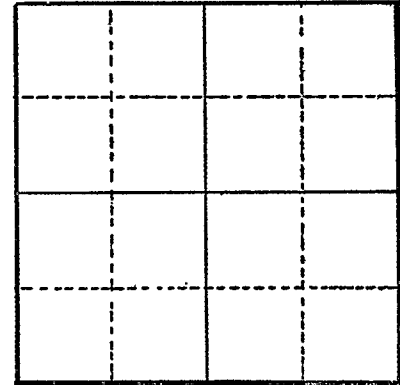

Section

Altitude at well

TYPE OF WELL: drilled Date Constructed 1952

Depth drilled 60 Depth cased 58

CASING RECORD:

6-inch

FINISH:

AQUIFERS:

Top soil, clay, sand and gravel

WATER LEVEL:

8-feet

PUMPING EQUIPMENT: Type Jet (Dorward) H.P. 3

Capacity 60 G.P.M.

WELL TESTS:

Drawdown 30 ft. after _____ hours Pumping 60 G.P.M.

Drawdown _____ ft. after _____ hours _____ G.P.M.

USE OF WATER irrigation Temp. _____ °F., 19.

SOURCE OF INFORMATION GR-2781

DRILLER or DIGGER

ADDITIONAL DATA:

Log X Water Level Measurements _____ Chemical Analysis _____ Aquifer Test _____

REMARKS:

Top soil	3	57		
Yellow clay	8	49		
Sandy clay	39	10		
Sand and gravel (water bearing)	10	0		