

STATE ENGINEER
Salem, Oregon

Jack
16450

Well Record

STATE WELL NO. 38/2W-11F
COUNTY Jackson
APPLICATION NO. GR-3874

OWNER: Donald H. Giles


MAILING ADDRESS: Route 4, Box 372

LOCATION OF WELL: Owner's No. _____

CITY AND STATE: Medford, Oregon

SE $\frac{1}{4}$ NW $\frac{1}{4}$ Sec. 11 T. 38 S., R. 2 W., W.M.

Bearing and distance from section or subdivision corner 1070' N. & 1028' E. from SW cor. DLG #47

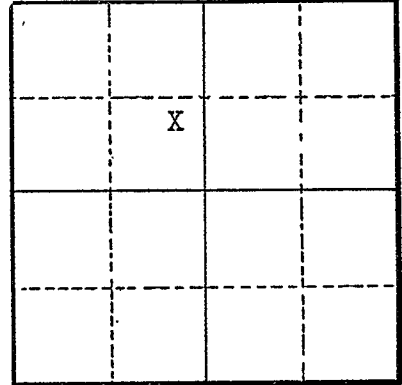

Section 11

Altitude at well _____

TYPE OF WELL: Dug Date Constructed 1900

Depth drilled 32 feet Depth cased 32 feet

CASING RECORD:

Well cased with rock from 0 to 32 feet

FINISH:

AQUIFERS:

WATER LEVEL:

15 feet below surface

PUMPING EQUIPMENT: Type Berkeley 1 1/4" centrifugal jet pump H.P. 1
Capacity 16.6 G.P.M.

WELL TESTS:

Drawdown 12 ft. after _____ hours 16.6 G.P.M.
Drawdown _____ ft. after _____ hours _____ G.P.M.

USE OF WATER Irrigation Temp. _____ °F. _____, 19____

SOURCE OF INFORMATION Well Registration Statement Cert. # GR-3524

DRILLER or DIGGER _____

ADDITIONAL DATA:

Log _____ Water Level Measurements _____ Chemical Analysis _____ Aquifer Test _____

REMARKS: