

STATE ENGINEER
Salem, Oregon

Jack
16757
Well Record

STATE WELL NO. 38/2W-16G
COUNTY Jackson
APPLICATION NO. GR-1737

GR- 1685

OWNER: Jack Nickles

MAILING

ADDRESS: Rt. 4, Box 381

LOCATION OF WELL: Owner's No. Sump


CITY AND

STATE: Medford, Oregon

SW $\frac{1}{4}$ NE $\frac{1}{4}$ Sec. 16 T. 38 S. R. 2 W., W.M.

Bearing and distance from section or subdivision

corner 1700' S. & 1620' W. from NE cor. Sec. 16

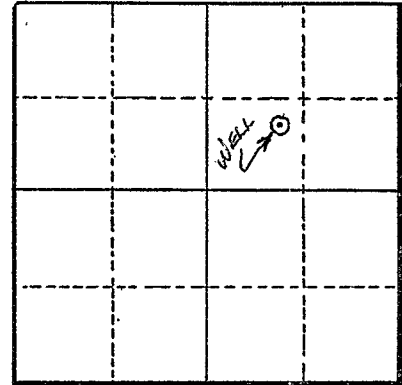

Section 16

Altitude at well 2070'

TYPE OF WELL: Dug Date Constructed 1953

Depth drilled 15' Depth cased Sump

CASING RECORD:

Infiltration trench - 30' x 70' x 15'

FINISH:

AQUIFERS:

WATER LEVEL:

2'

PUMPING EQUIPMENT: Type Wards 1 $\frac{1}{2}$ " x 2" Cent. H.P. 8
Capacity 75 G.P.M.

WELL TESTS:

Drawdown 6 ft. after hours 200 G.P.M.

Drawdown ft. after hours G.P.M.

USE OF WATER Irrigation Temp. °F. 19

SOURCE OF INFORMATION GR Record

DRILLER or DIGGER Tru-Mix Concrete Co.

ADDITIONAL DATA:

Log Water Level Measurements Chemical Analysis Aquifer Test

REMARKS:

Log: Top Soil 0 to 2 ft.
Gravel & clay (water bearing) 2 to 15 ft.
Bedrock at 15 ft.

Irrigation of 3 acres.