

STATE ENGINEER
Salem, Oregon

Jack
17450


Well Record

STATE WELL NO. 38/3W-33Q(1)
COUNTY Jackson
APPLICATION NO. GR-652

OWNER: Boyd & Lucille Hamilton MAILING ADDRESS: Route 1, Box 63

LOCATION OF WELL: Owner's No. 1 CITY AND STATE: Jacksonville, Oregon

N. E.
SW 1/4 SE 1/4 Sec. 33 T. 38 S., R. 3 W., W.M.
Bearing and distance from section or subdivision
corner Approx. 13 chs. S. & 2.65 chs. W. of
NE cor. DLC 41

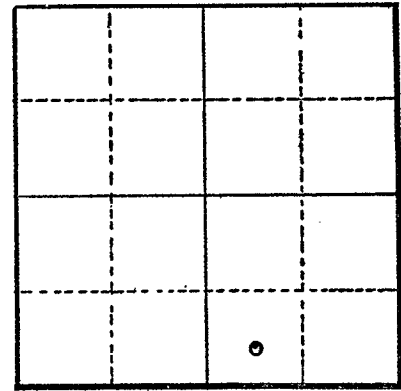

Section 33

Altitude at well 1400' Interpolated

TYPE OF WELL: Dug Date Constructed 1896

Depth drilled 16 Depth cased _____

CASING RECORD:

36 inch

FINISH:

AQUIFERS:

WATER LEVEL:

5 feet

PUMPING EQUIPMENT: Type Palmer H.P. Tractor
Capacity 845 G.P.M.

WELL TESTS:
Drawdown 4 ft. after _____ hours 845 G.P.M.
Drawdown _____ ft. after _____ hours _____ G.P.M.

USE OF WATER Irrigation 10 acres Temp. _____ °F., 19 _____

SOURCE OF INFORMATION GR-652

DRILLER or DIGGER _____

ADDITIONAL DATA:
Log _____ Water Level Measurements _____ Chemical Analysis _____ Aquifer Test _____

REMARKS: