

STATE ENGINEER
Salem, Oregon

Jack
17596 **Well Record**

STATE WELL NO. 38/4W-6E(1)
COUNTY Jackson
APPLICATION NO. GR-589

OWNER: Finis H. Smith


MAILING ADDRESS: Route 4, Box 523

LOCATION OF WELL: Owner's No. _____

CITY AND STATE: Grants Pass, Oregon

SW $\frac{1}{4}$ NW $\frac{1}{4}$ Sec. 6 T. 38 ^{N.} S., R. 4 ^{E.} W., W.M.

Bearing and distance from section or subdivision corner _____

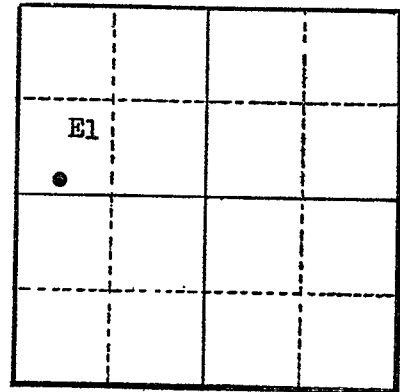

Altitude at well 1190' Interpolated

TYPE OF WELL: Dug Date Constructed May '48

Depth drilled 13' Depth cased _____

Section 6

CASING RECORD:

180' x 50' trench

FINISH:

AQUIFERS:

WATER LEVEL:

4'

PUMPING EQUIPMENT: Type Centrifugal H.P. 15
Capacity 510 G.P.M.

WELL TESTS:

Drawdown 2.5 ft. after _____ hours 510 G.P.M.
Drawdown _____ ft. after _____ hours _____ G.P.M.

USE OF WATER Irrigation 46 acres Temp. _____ °F. _____, 19____

SOURCE OF INFORMATION GR-589

DRILLER or DIGGER _____

ADDITIONAL DATA:

Log _____ Water Level Measurements _____ Chemical Analysis _____ Aquifer Test _____

REMARKS:

Sandy loam 9 to 13'
Gravel (water bearing) 0 to 9' ??