
NOTICE TO WATER WELL CONTRACTOR The original and first copy of this report are to be filed with the

WATER RESOURCES DEPARTMENT. SALEM, OREGON 97310 within 30 days from the date

(Do not write above this line) SOURCES DEPT tate Permit No. of well completion. (1) OWNER: (10) LOCATION OF WELL: Driller's well number 4 Section 33 T. 39 SR. 3-1 Bearing and distance from section or subdivision corner (2) TYPE OF WORK (check): TAX 107 307 New Well Deepening | Reconditioning | Abandon 🔲 If abandonment, describe material and procedure in Item 12. (11) WATER LEVEL: Completed well. (3) TYPE OF WELL: (4) PROPOSED USE (check): Depth at which water was first found Rotary Driven 🛘 Domestic | Industrial | Municipal | Cable ft. below land surface. Date Jetted Irrigation | Test Well | Other Dug Bored | Artesian pressure lbs. per square inch. Date CASING INSTALLED: Threaded | Welded |4-(12) WELL LOG: Diameter of well below casing O. " Diam. from # 1 ft. to 54 ft. Gage 1250 Depth drilled 25 Oft. Depth of completed well " Diam. from _____ft. to _____ft. Gage ____ Formation: Describe color, texture, grain size and structure of materials; and show thickness and nature of each stratum and aquifer penetrated, with at least one entry for each change of formation. Report each change in PERFORATIONS: position of Static Water Level and indicate principal water-bearing strata. Perforated? | Yes | No. Type of perforator used MATERIAL. From Size of perforations in. by perforations from _____ ft. to perforations from _____ ft. to _____ ft. perforations from _____ ft. to ____ (7) SCREENS: Well screen installed? | Yes Manufacturer's Name Diam. Slot size Set from ft. to ... Diam. Slot size Set from (8) WELL TESTS: Drawdown is amount water level is lowered below static level Was a pump test made? [] Yes [] No If yes, by whom? gal./min. with ft. drawdown after 100 gal./min. with 269st. drawdown after Artesian flow g.p.m. perature of water Depth artesian flow encountered Work started 5 -3/19 78 Completed Date well drilling machine moved off of well (9) CONSTRUCTION: Well seal-Material used CEMIENT **Drilling Machine Operator's Certification:** This well was constructed under my direct supervision. Well sealed from land surface to 25 Materials used and information reported above are true to my best knowledge and belief. Diameter of well bore to bottom of seal 10 in. Diameter of well bore below seal Number of sacks of cement used in well seal (Drilling Macrine Operator) How was cement grout placed? Drilling Machine Operator's License No. Water Well Contractor's Certification: This well was drilled under my jurisdiction and this report is true to the best of my knowledge and belief. Was a drive shoe used? Yes 🗌 No Plugs Size: location Did any strata contain unusable water? 🗌 Yes 🐼 No Type of water? depth of strata Method of sealing strata off Was well gravel packed? [] Yes [No Size of gravel:

Contractor's License No. 689 Date 6-2-78, 19/

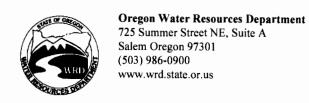

Application for Well ID Number RECEIVED

MAY 3 1 2011

Do not complete if the well already has a Well I.D Number.

WATER RESOURCES DEPT SALEM OREGON

Mailing Address (to send Well I.D.):	ion:1/4
Mailing Address: 7740 UPPER APPLEGATE RD. City: JACKSONVILLE State: OR Zip: 9 Mailing Address (to send Well I.D.): SAME City: State: Zip:	ion:1/4
City: State: CR Zip: 9 Mailing Address (to send Well 1.D.): State: Zip: L. WELL INFORMATION (Do not complete this section if the well report is attached.) Township: (North/South) Range: (East/West) Section at time the well was constructed, (if known): City: C	ion: 1/4

City: State: Zip:	ion: 1/4
Cownship:(North/South) Range:(East/West) Section	
Street Address of Well: City: Owner at time the well was constructed, (if known): If the property had a different street address in the past:	
se of Well (domestic, irrigation, commercial, industrial, monitoring): Oute Well Constructed: Total Well Depth: Casing Diameter	
Other Information:	
UBMITTED BY (please print): DAVID SCIMECA HONE: 541 899 - 9967 FAX:	
NOTE; WELL REPORT LIST TAX LOT AS 307. IN	2003 THE
TAX LOT NUMBER WAS CHANGED TO 328.	
TAX LOT NUMBER WAS CHANGED 10 328.	
	1-1266; fax (503) 986-
902. Applications are processed and Well I.D. Numbers are mailed every Wednesday.	1-1266; fax (503) 986-
end application to Oregon Water Resources Department; 725 Summer St NE, Suite A; Salem, Oregon 9730 902. Applications are processed and Well I.D. Numbers are mailed every Wednesday. For Official Use Only by the Oregon Water Resources Department: Received Date: Well Log Number: Well Ident JACK 18438	