

STATE ENGINEER
Salem, Oregon

Jack
18448

Well Record


STATE WELL NO. 39/3W-33N(1)
COUNTY Jackson
APPLICATION NO. GR-613

OWNER: David B. Winningham MAILING ADDRESS: Route 2, Box 63-A

LOCATION OF WELL: Owner's No. 1 CITY AND STATE: Jacksonville, Oregon

SW $\frac{1}{4}$ SW $\frac{1}{4}$ Sec. 33 T. 39 ^{N.} S., R. 3 ^{E.} W., W.M.

Bearing and distance from section or subdivision corner

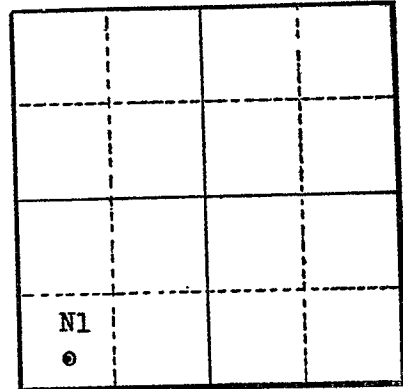

Section 33

Altitude at well 1623 Interpolated

TYPE OF WELL: Dug Date Constructed Feb 15 '50

Depth drilled 16 Depth cased

CASING RECORD:

Sump: 50' x 320' x 16' deep

FINISH:

AQUIFERS:

WATER LEVEL:

4' (est.)

PUMPING EQUIPMENT: Type Cornell centrifugal H.P. 7 1/2
Capacity 2000 G.P.M.

WELL TESTS:

Drawdown _____ ft. after _____ hours _____ G.P.M.
Drawdown _____ ft. after _____ hours _____ G.P.M.

USE OF WATER Irrigation 60 acres Temp. _____ °F. _____, 19

SOURCE OF INFORMATION GR-613

DRILLER or DIGGER _____

ADDITIONAL DATA:
Log _____ Water Level Measurements _____ Chemical Analysis _____ Aquifer Test _____

REMARKS: